



500-17-11-12.

Form No. 2.

ORDERS UNDER SECTION 96 (2) OF ACT III OF 1910.

No. E/

1369 OF 1913.

MUNICIPAL ENGINEER'S OFFICE,

Karachi,

1913.

MEMO:

With reference to his application dated 18th Dec 1913.

Mr. Motiram Lalchand is informed

that the plan submitted by him for building three floor

on plot No. 18 Survey Sheet 22

situate in Beglar Street at Car

Quarter, is approved, and permission to build in accordance therewith is granted. The building to be erected subject to the Byelaws and Rules of the Municipality.

A. M. INST., C. E.,

Engineer,

Karachi Municipality.

NOTE 1.—This pass does not give permission to occupy Municipal land with building materials. This can only be allowed when the street is wide enough to permit building materials being deposited on it without it being a source of danger to the public, and only then on a hoarding being placed round the land to be occupied, and on payment in advance of fees for occupation of Municipal land, at the following rates:—

				Rs.	A.	P.
(1)	For the first three months, per square yard, per diem	...	0	0	$\frac{1}{2}$	
(2)	For the next three months ,, ,, ,,	...	0	0	1	
(3)	For any subsequent time ,, ,, ,,	...	0	0	2	

NOTICE 2:—Windows and doors of the building will not be permitted to project on or overhang any public street or Municipal land.



(200-14-2-13.

Form No. 5.

No. E. 1370 of 1913.

MUNICIPAL ENGINEER'S OFFICE,

Karachi, 13th March 1913.

MEMO.

Inspector P. A. 2 Quarter is informedthat M. Mohan Lal has been permittedto live there his houseon plot No. P. A. 2 Street P. A. 2

Quarter. Report should be made to the undersigned when the house is

completed.

M. M.
M. M.
A. M. INST. C. E.,

Engineer,

Karachi Municipality.

Through the Health Officer, Karachi Municipality.



Heritage

KMR.CDD.OIQ.1913.01

3-1

500-27.7.1912.

Form No. 1.

Karachi, 10th February 1913.

NOTICE UNDER SECTION 96 OF ACT III OF 1901.

To

THE CHIEF OFFICER AND CHIEF ENGINEER,

KARACHI MUNICIPALITY.

SIR,

I beg to inform you that I intend building Kvris plan
on plot No. 18

Survey Sheet No. A 2 Situate in Rampart Row

Street old Inn Quarter.

As required by the rules of the Municipality, I beg to submit herewith
a plan of the same for your approval.

I beg to remain,

Sir,

Your most obedient Servant,

[Signature]
Signature of the applicant.

No. G. of 1622 1913.

MUNICIPAL CHIEF OFFICER AND

CHIEF ENGINEER'S OFFICE.

Karachi, 16th February 1913.

Forwarded to the Municipal Engineer for favour of disposal.

[Signature]

A. M. INST. C. E.,

Chief Officer and Chief Engineer,

Karachi Municipality.

Mr Benjamin
Shaw to H.O.

No. E. 984 of 1913.

MUNICIPAL ENGINEER'S OFFICE.

Karachi, 21st February 1913.

MEMO.

The above application is forwarded to the Municipal Health Officer for
favour of report.

Through

Land Surveyor

A. M. I. C. E.

A. M. I. C. E.,

Engineer,

Karachi Municipality.

MUNICIPAL HEALTH OFFICER'S REPORT.

Returned to the Engineer, Karachi Municipality, with the following
remarks—

*No objection**D. P. H.*

D. P. H. (London)

Health Officer,

Karachi Municipality.

Date 3-3-1913

No. E. 1101 of 1913.

MUNICIPAL ENGINEER'S OFFICE.

Date 4th March 1913.

Forwarded to the Enquiry Officer for report.

A. M. I. C. E.,

Engineer,

Karachi Municipality.

Through

The Land Surveyor,

Karachi Municipality.



3-3

3

ENQUIRY OFFICER'S REPORT.

Applicant's name M. Motran Salhan

Whether he is the owner of the plot on which it is proposed to build _____

The work proposed to build 3rd floor

CHIEF ENG.

KARACHI MUNICIPALITY

Enquiry Officer's report

By S. H. Khan
Work to be done on above plot is plan of the building
to be done in accordance with the plan of the building
Date 5th Nov 1913.
Enquiry Officer.

Submitted through the Land Surveyor.

LAND SURVEYOR'S REPORT.

Does the plot come under Alignment no

Area of plot _____

Area under Alignment _____

Remarks Sir, With reference to this S. H. Khan's
report that there is no objection to permission
to be granted.

Date 10-3 1913.

Yours aty S.
Nathani
Land Surveyor.

ORDERS OF THE ENGINEERS.

Issue passM. H. Khan

A. M. I. C. E.,

Engineer,

Karachi Municipality.



3-4

No. E. ⁴ 1383 of 1913.

MUNICIPAL ENGINEER'S OFFICE.

Karachi, 15th March 1913.

Submitted to the M- ittee with a recommendation that the plan be approved.

From

M. I. C. E.

A. M. I. C. E.,

Engineer,


Karachi Municipality.

Through


THE CHIEF OFFICER AND CHIEF ENGINEER,
KARACHI MUNICIPALITY.

RESOLUTION OF THE MANAGING COMMITTEE.


Resolution No. _____ Date _____

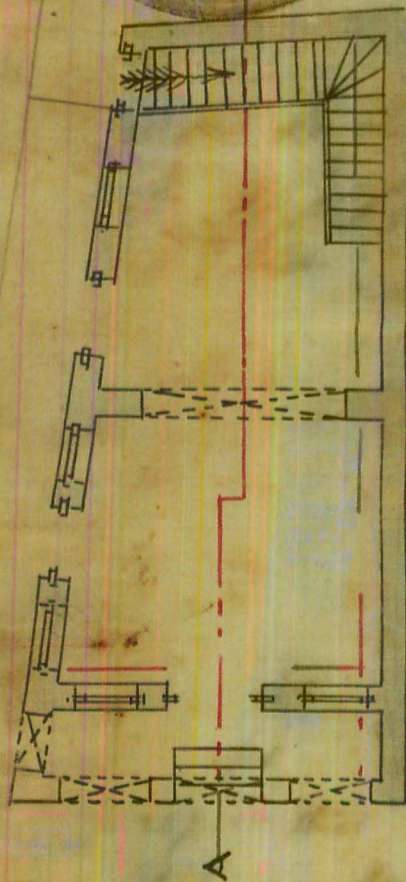


GROUND FLOOR

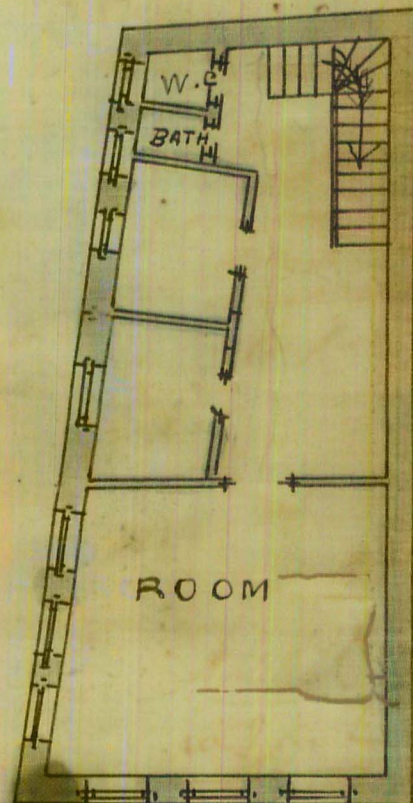

1ST. FLOOR

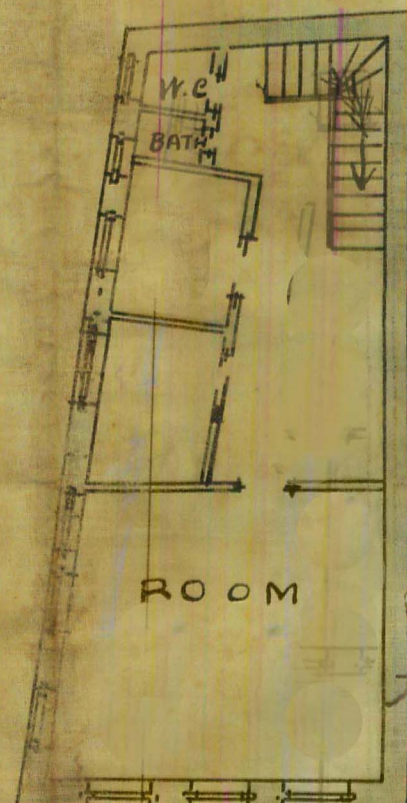


2ND. FLOOR

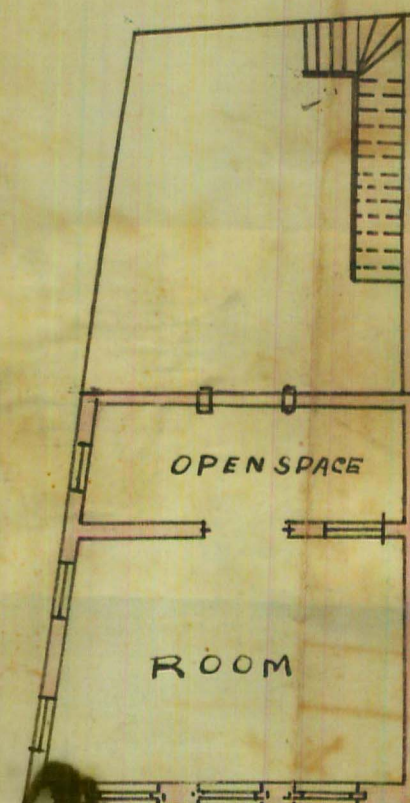

3RD FLOOR

The revise plan showing the 3rd. floor—
to be built on plot N^o 18-A2. Old Town G^r.—
Scale 10 feet to 1 inch.—

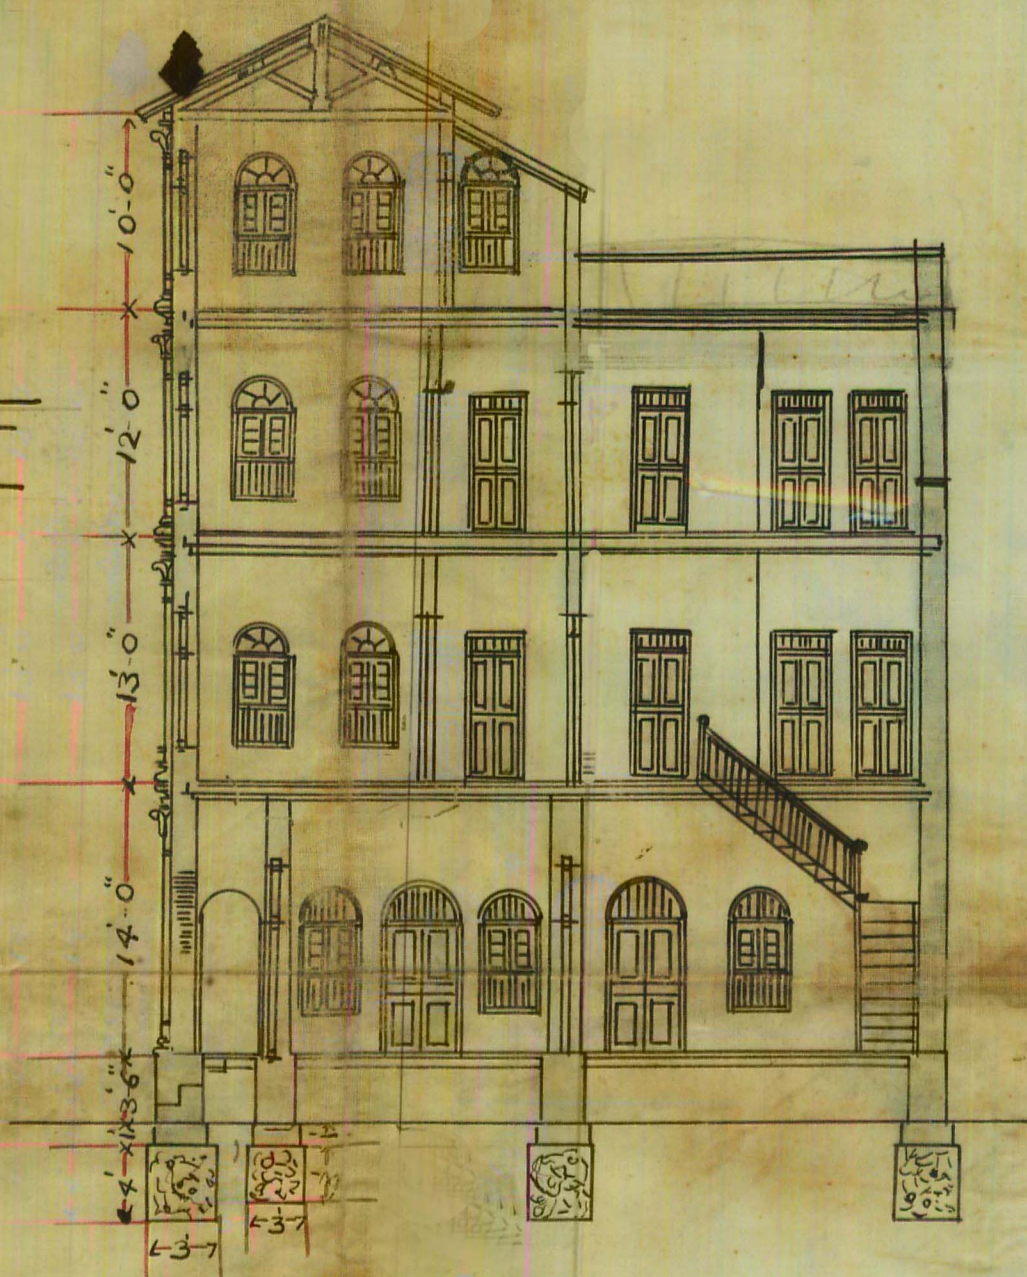

SECTION ON A.B.

BLOCK PLAN

SCALE 20' = 1"



13/4/13
Engineer
Kuttah