



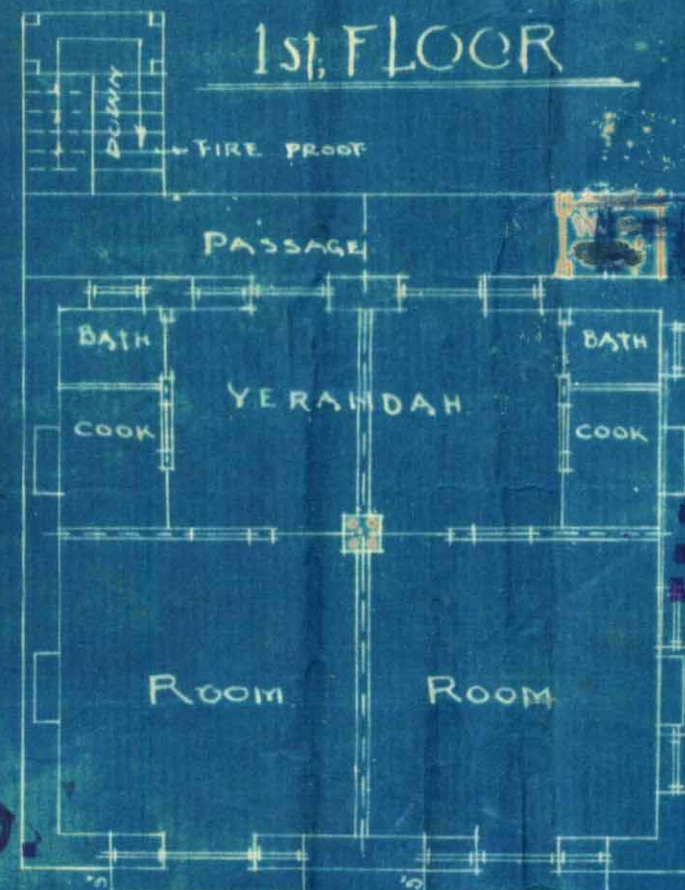

PLAN SHOWING PROPOSED BUILDING ON THE PART OF PLOT No 24 LR7 LAWRENCE QRT. SCALE 8" to 1"

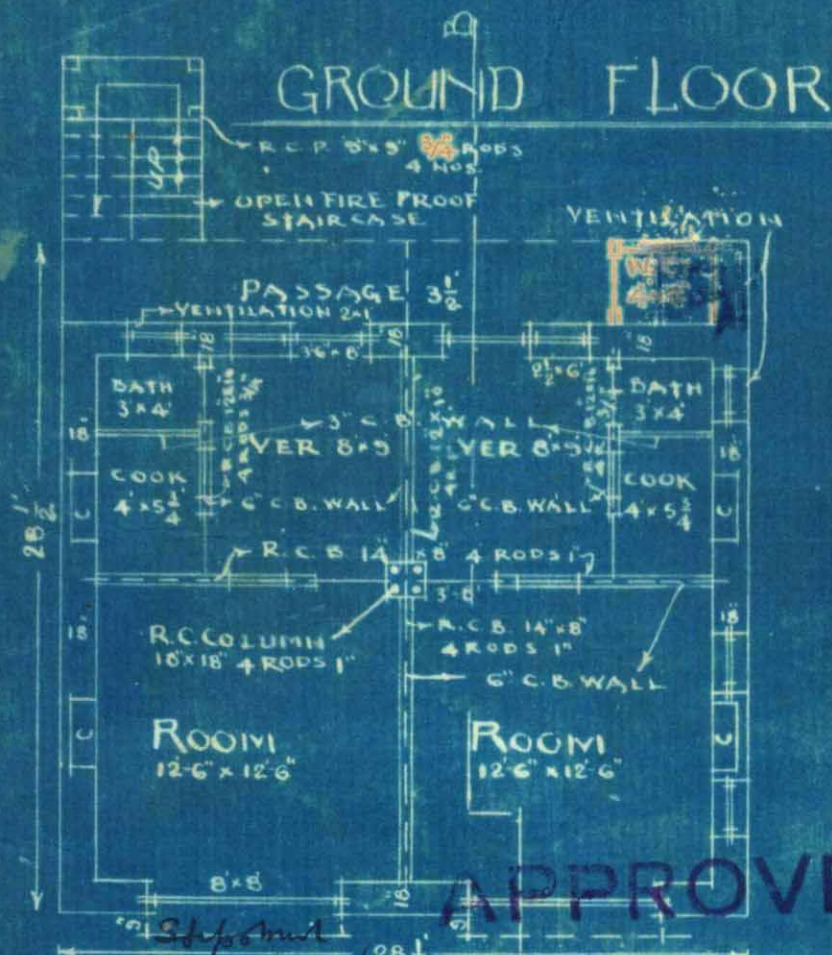


APPROVED

A. F. Modi
28/7/32

Notes: Rooms will be made to open in the inner limit.

SECTION ON A.B.

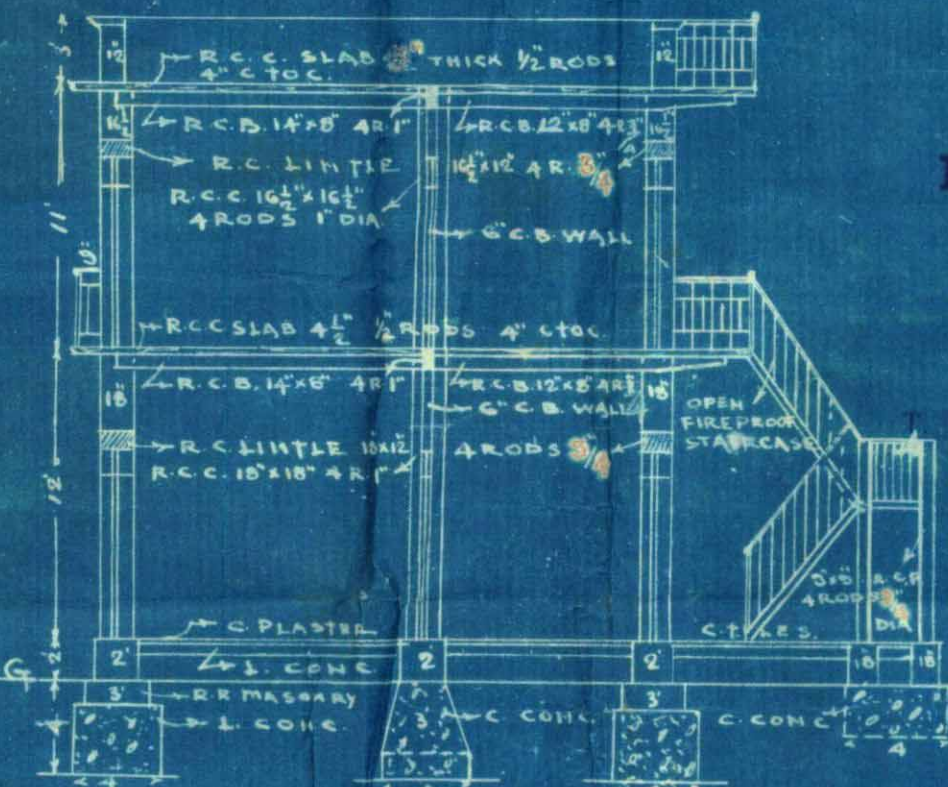

NOTE,
AREA OF THE ENTIRE PLOT 4032 2/3 SQ YOS.
EXISTING BUILT UPON AREA 1107 "
PROPOSED AREA 81.22 "

NO OBJECTION.


ARBITRATOR
P. Scheme Karachi No II
Garden Quarter. 21-7-32

Notes:
Plan is approved subject to the following conditions:-
1. This sanction does not entitle the owner to build on land not conveyed to him either by the Govt or the Municipality by a separate sanction for a separate purpose.

TRUSTEE

ARCHITECT & SURVEYOR
WATERCOURSE ROAD
KARACHI.

FRONT ELEVATION



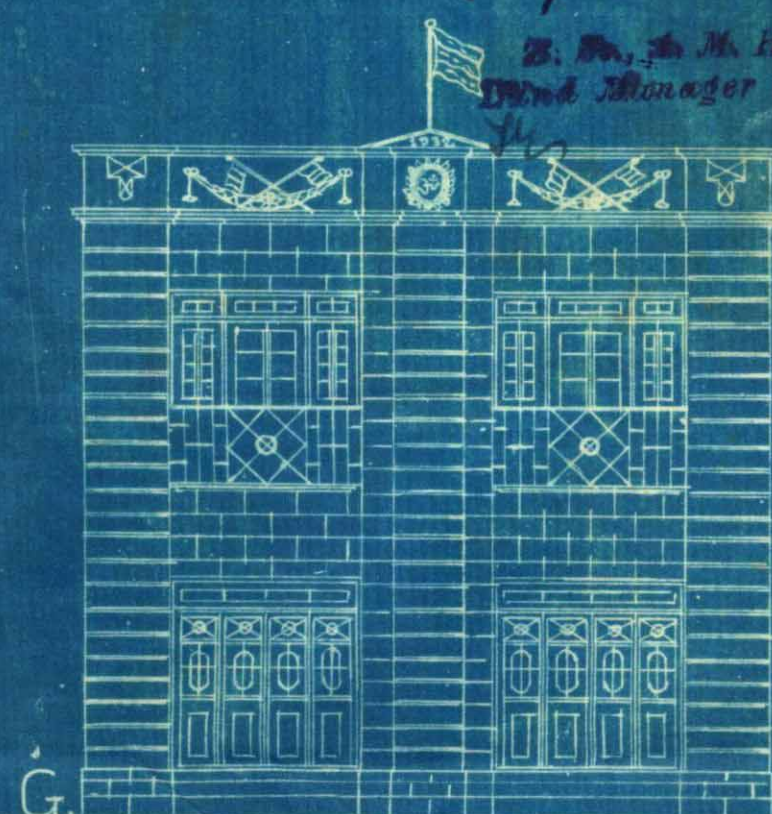





Heritage KMR

CDD.LaQ.1932.01


PLAN SHOWING PROPOSED BUILDING
ON THE PART OF PLOT No 24 L.R.7 LAWRENCE QRT.
SCALE 8' to 1"

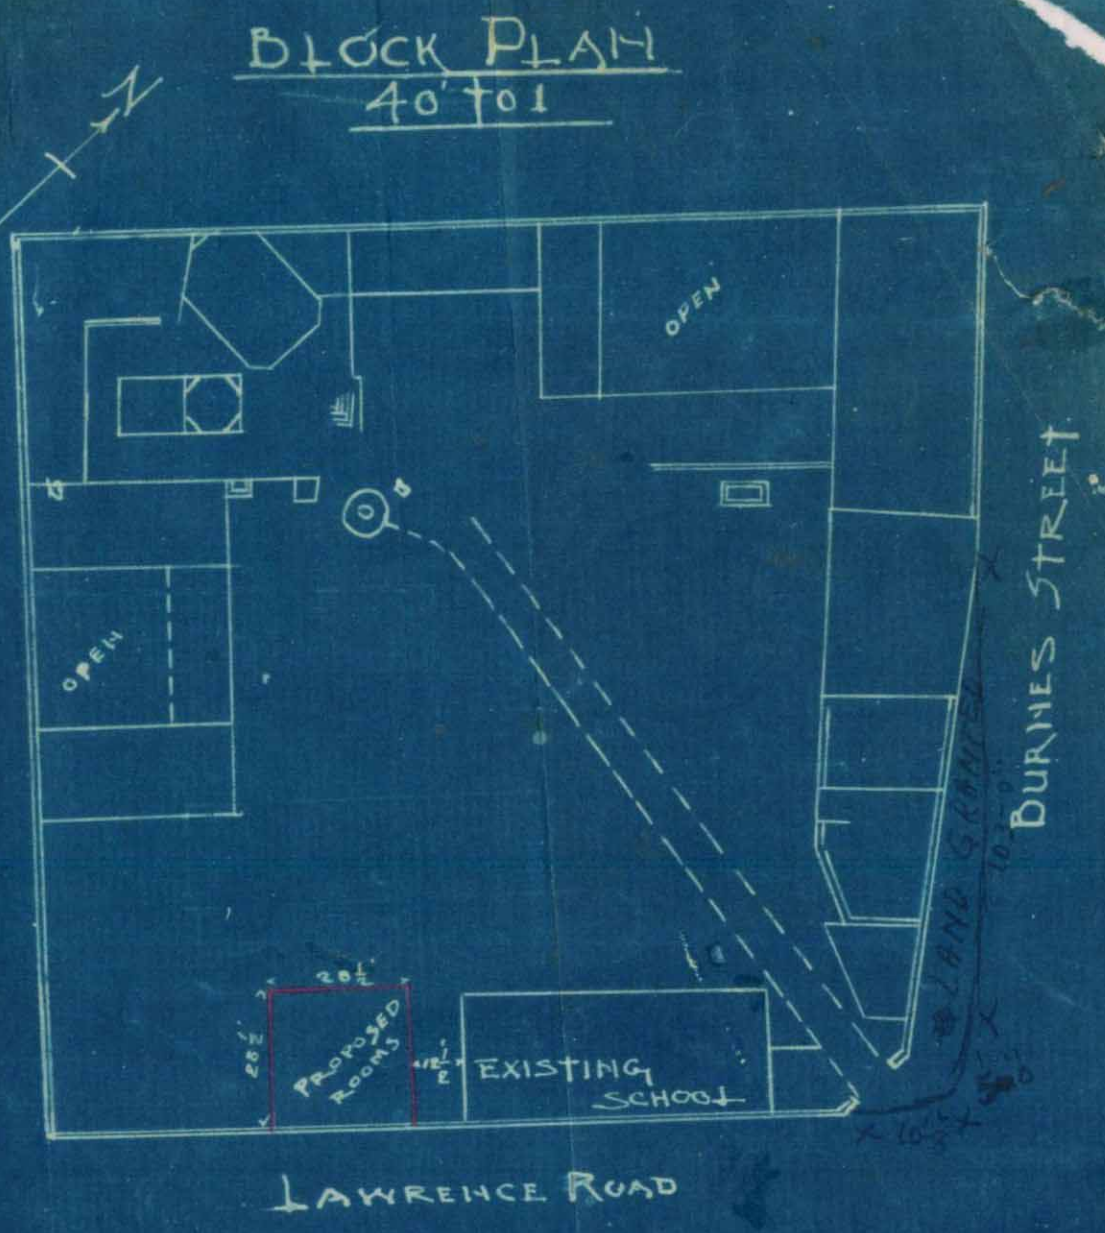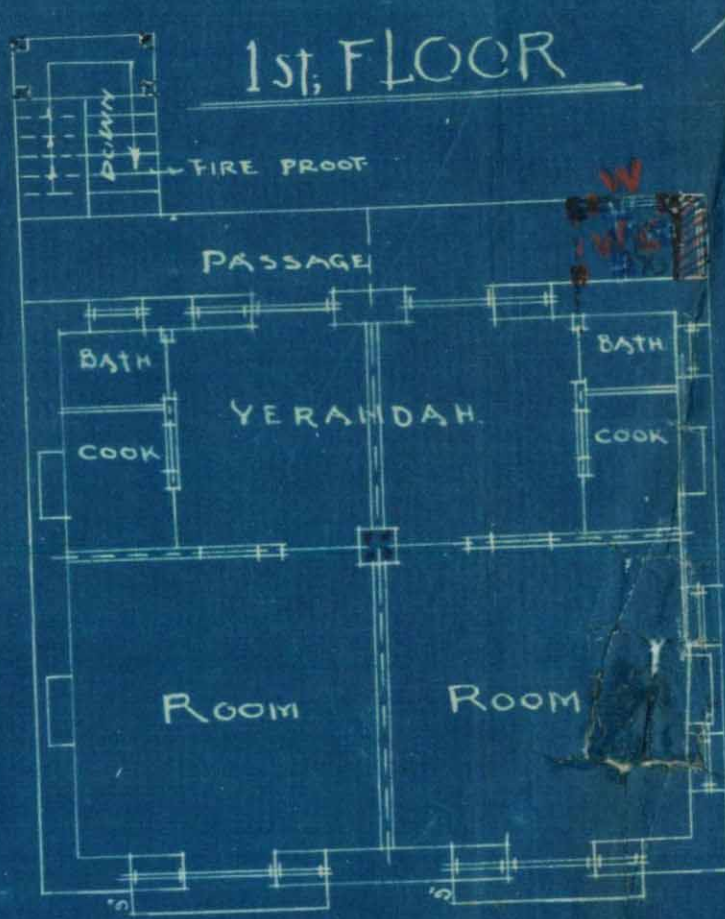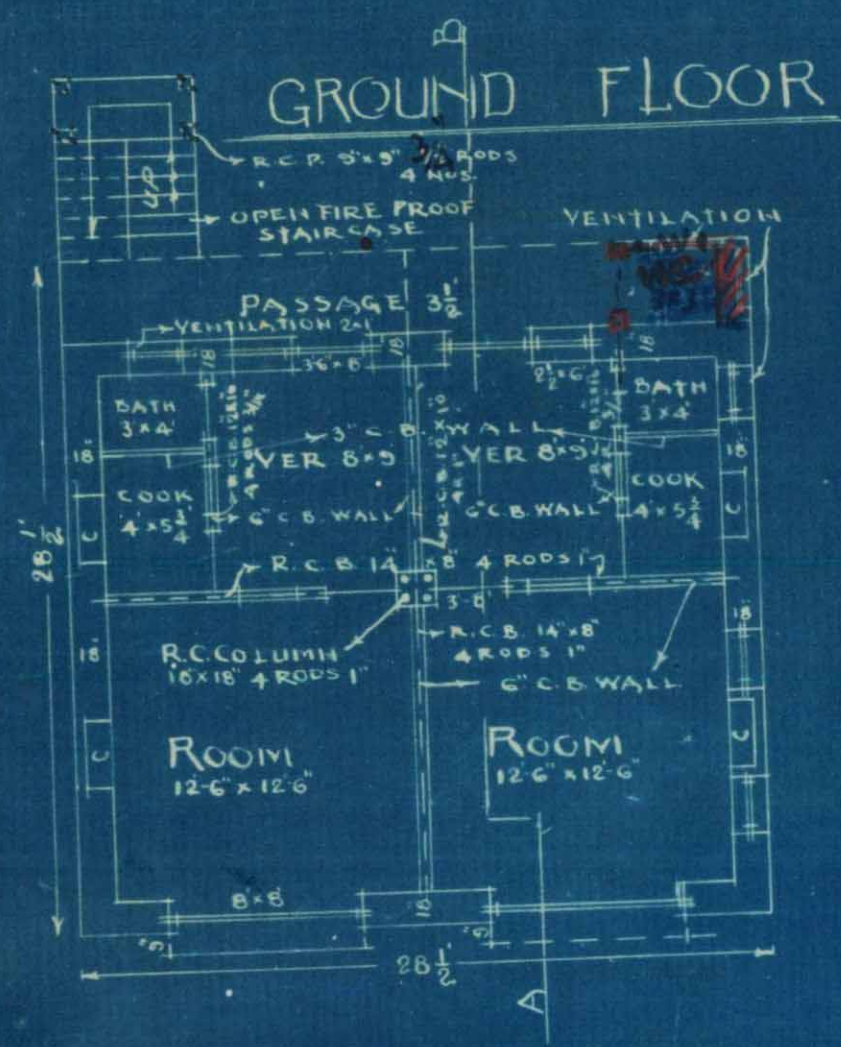

SECTION ON A.B.

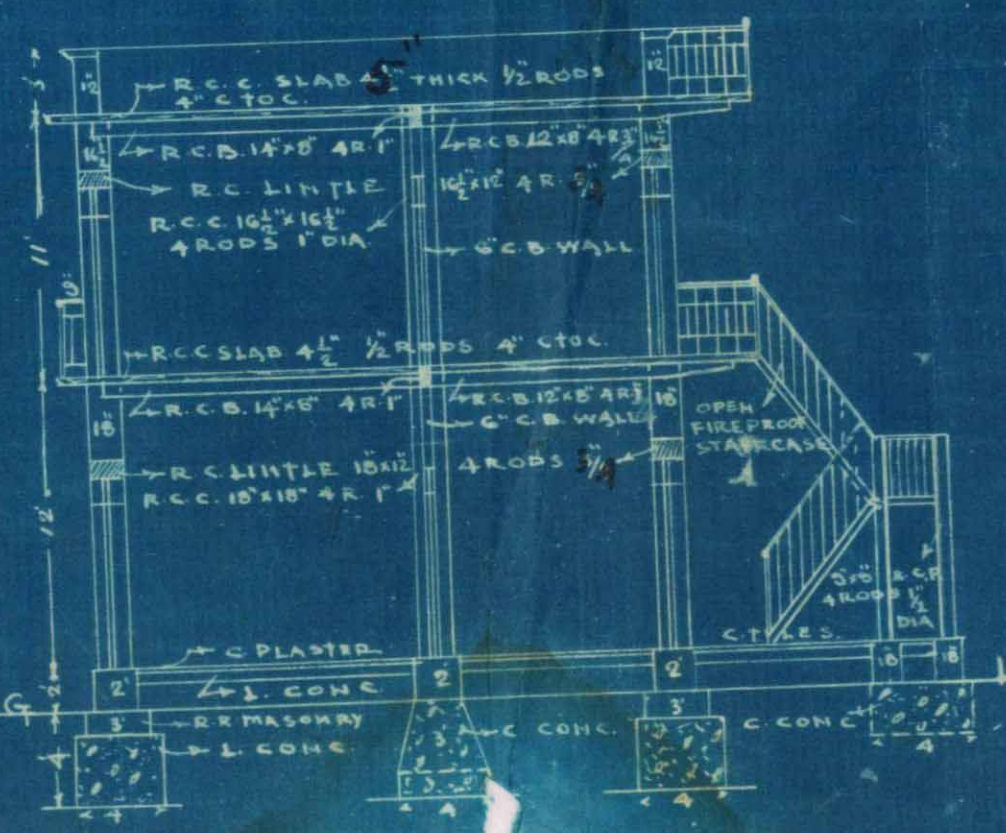

NOTE,
AREA OF THE ENTIRE PLOT 4032 2/3 SQ YDS.
EXISTING BUILT UPON AREA 1107 "
PROPOSED AREA 81.22 "

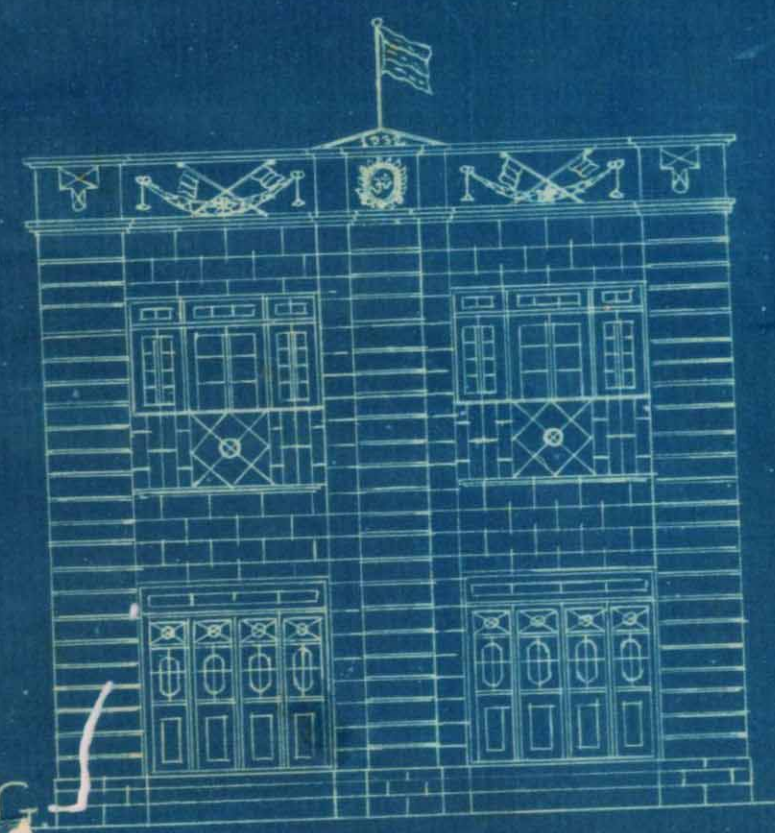

32/11/2017
23/8/2017
TRUSTEE

ARCHITECT & SURVEYOR
WATERCOURSE ROAD
KARACHI.