

N. J. MODI.

B. Sc. Engineering London.

A. M. INST., C. E., L. C. E.

A. M. I. S. E., M. R. San. I.

Land Manager & Architect.

No. L. M. A./BS. P. B. 86/81 of 1931

MUNICIPAL OFFICE,

KARACHI, 24/4 1931

MEMO:

Building Surveyor Section C is informed
that Mr. Nathalal Kumerji has been permitted
to build
his house
on plot No. 10 R. 8-4 Dameswari Street
Quarter. Report should be made to the
undersigned when house is completed.

Impressed

P.S.
Pl. This may be
retained in your section.

BS. 29-300-11-29.
BS. 29-300-8-30.

P.S.
To check the boundary
so that the completion
report may be put up

B.S.

The owner is to be notified
this date is within his own limit.


B. SC., A. M. INST. C. E.

Land Manager & Architect.

26/10/31



1-2

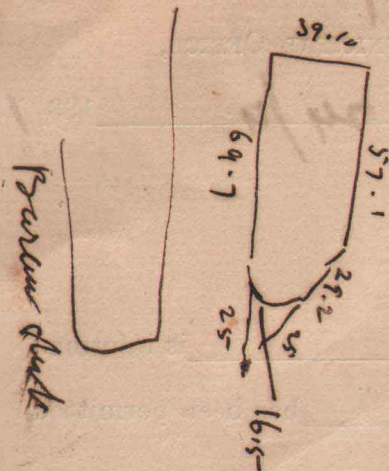

P. will be the architect to submit amended plans and completion certificate. The building is twice long occupied.

21/XI

2.2
so that the building
is not too long
and too narrow

11/11/21




Heritage

KMR.CDD.RaQ.1931.03

PLAN OF PROPOSED BUILDING ON PLOT No. 10.



SHEET No.R-5.4. RAMSAWAMYQR

SCALE 8-1/4" CH.

APPROVED.




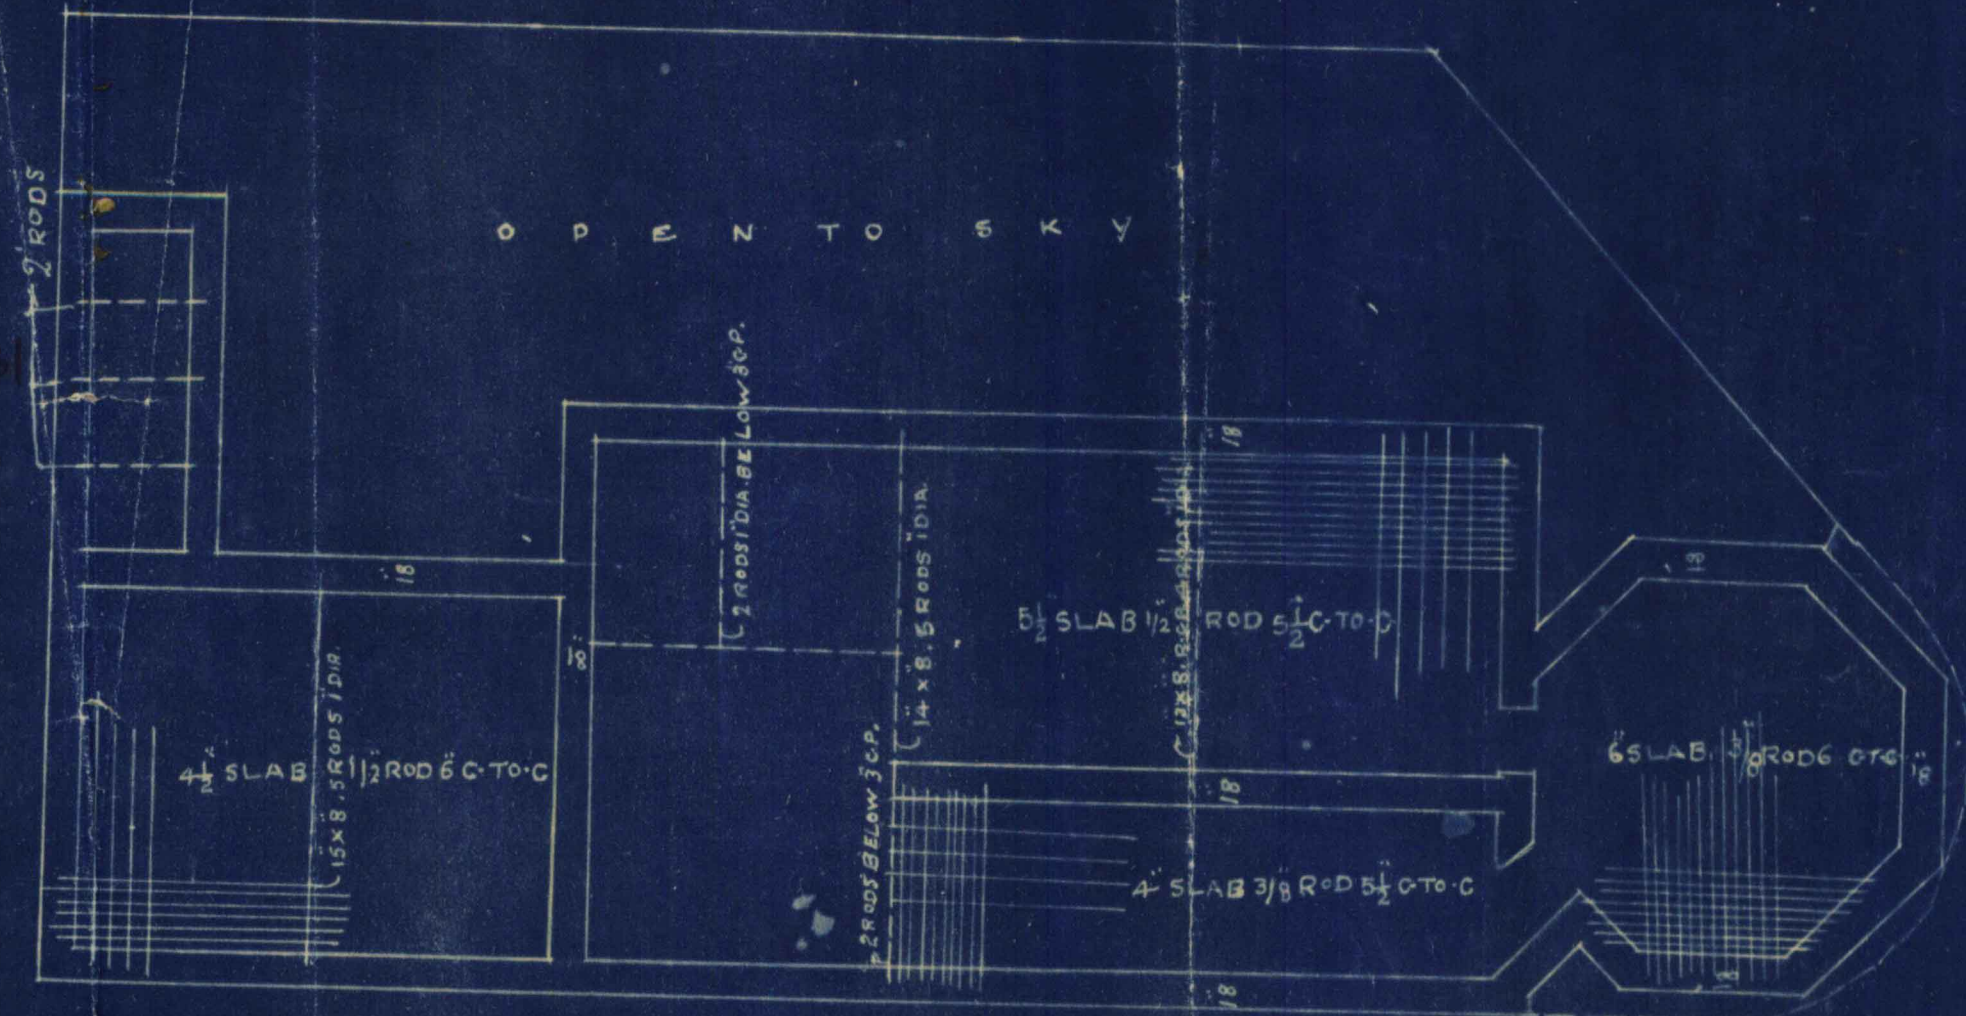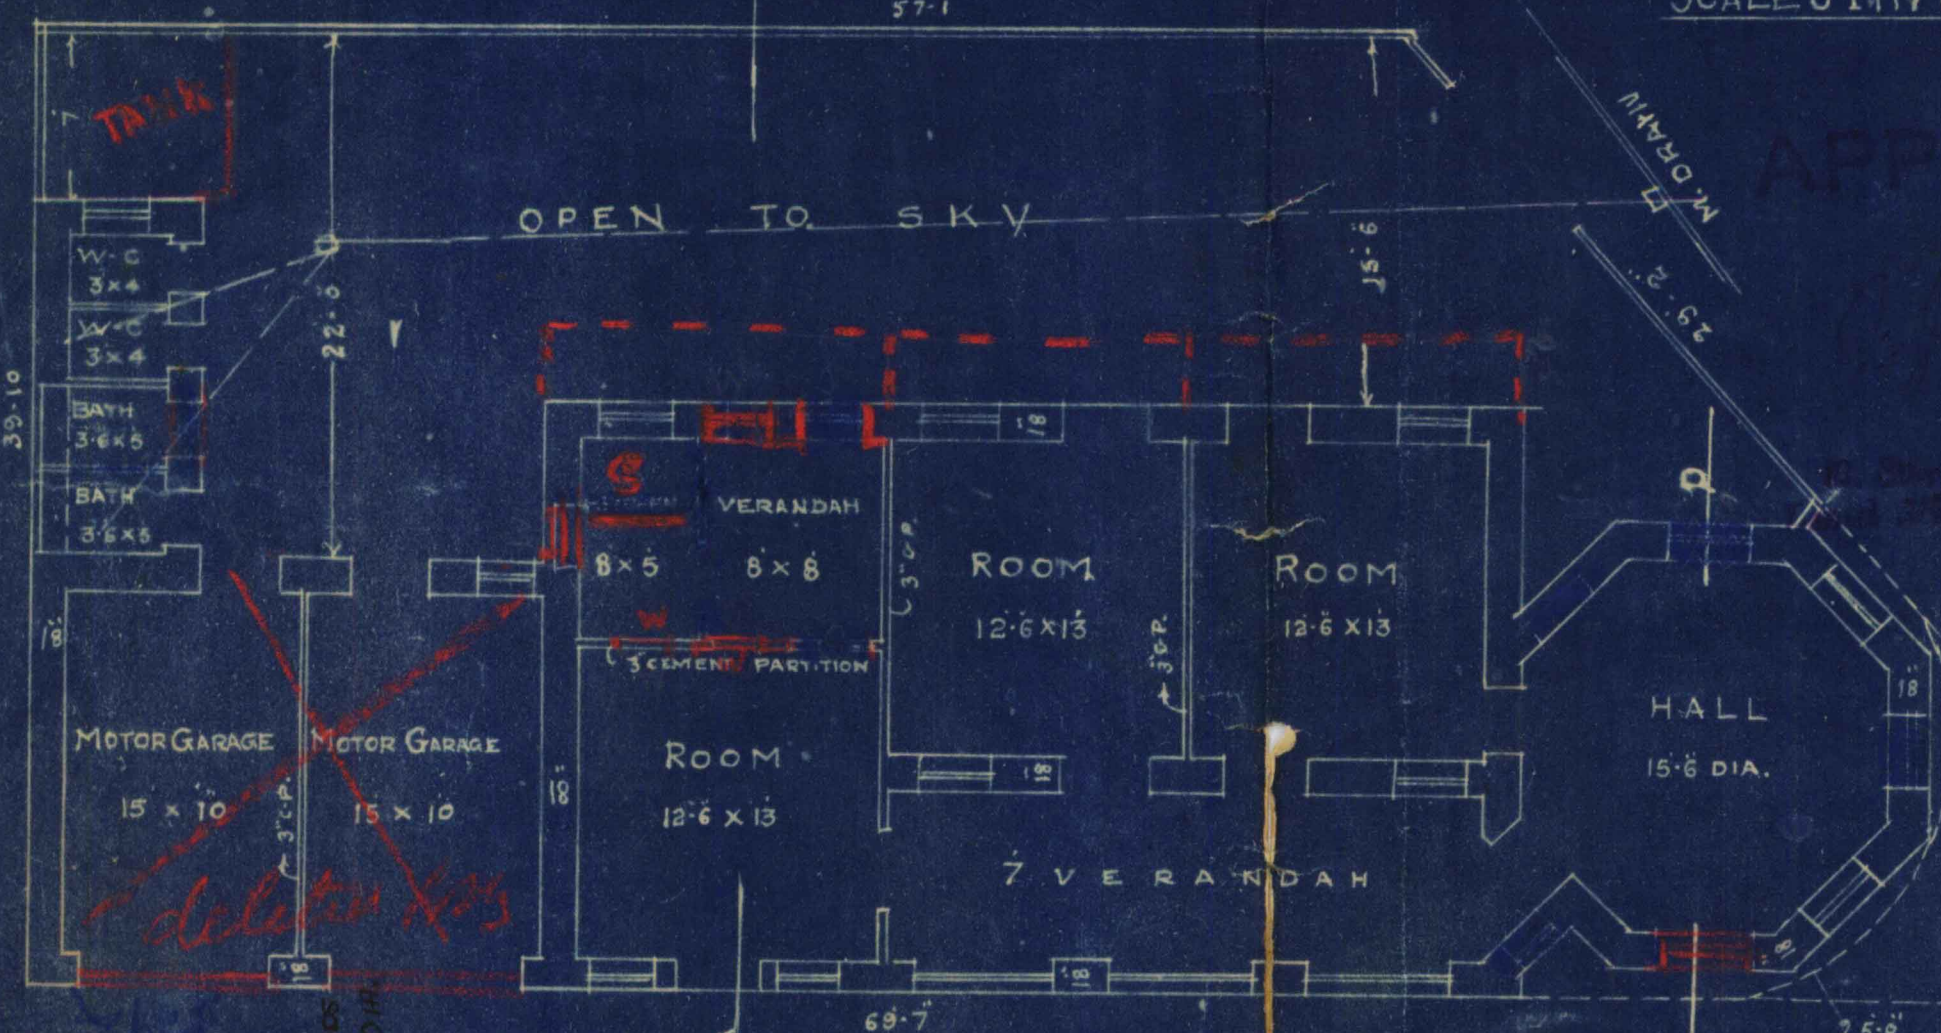

NOTE:-
TOTAL AREA :- 319 Sq. Yds.
COVERED " :- 200 " "
OPEN " :- 119 " "



B.V. Bhinde 5/2/51
B.E (Civil)
ARCHITECT

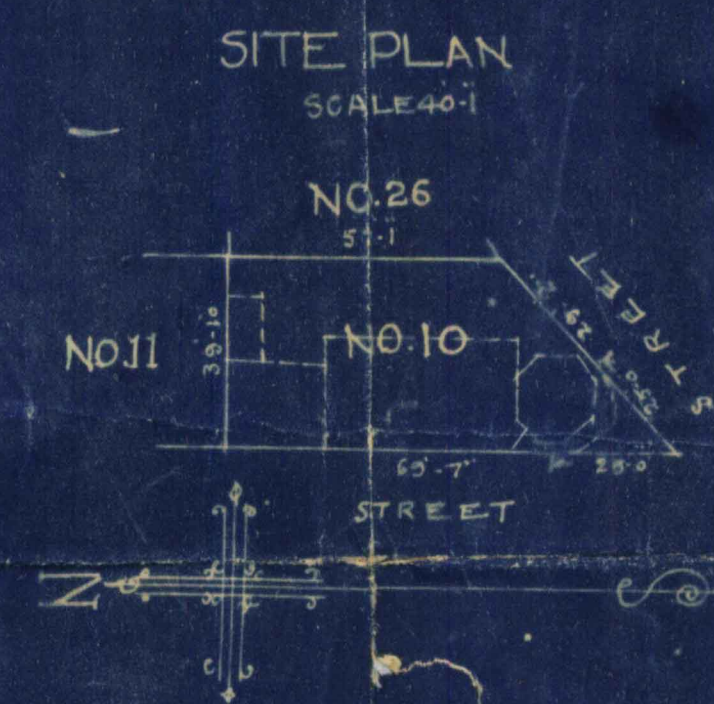

OWNER:- Nathulal Khurana

GOKADAS & BHINDE
BUNDE ROAD
KARACHI.

