



Heritage

KMR.CDD.MiQ.1916-1918.01(G)

No: E/-

2401

of 1918

Municipal Office

Karachi 4th March 1918.

M E M O :-

With reference to his application dated 25th February 1918 on behalf of the owners of Plot Nos: 15 and 16 D 1 Jail Quarter submitting ammended Plans for the proposed alterations in elevation of the proposed building on the above plot, Mr: D. H. Daroowalla Architect is informed that there is no objection to the same and the Plan as submitted is approved.

J. A. H. Kirby

A. M. Inst., C. E.,

Engineer

Karachi Municipality.

No: E/- ²⁴⁰² ~~2401~~ of 1918

Municipal Office

Karachi 4th March 1918

Copy forwarded to the Building Surveyor with copies of plans for Plot Nos: 15 and 16 - D 1 Jail quarter for information and guidance.

J. A. H. Kirby

A. M. Inst., C. E.,

Engineer


Karachi Municipality.

MISTRI & BHEDWAR,

B.A's., L.C.E's.,
ARCHITECTS, ETC.

D. H. Daruvala B.E.

Representative

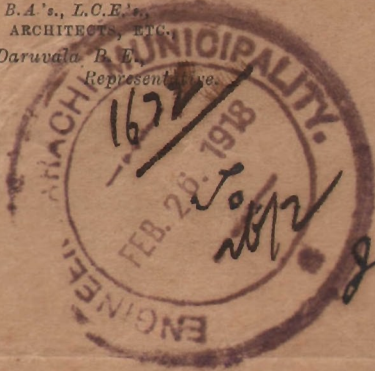

*L.S. for
repro & co.
sent to Mr. V.*

G2
Lawaham RoadKarachi, 25th February 1918

J. Cecil L. Verley Esq. A.M.I.C.E.
Engineer
Karachi Municipal

Sir,

On behalf of the owners, I have the
honour to send you herewith amended
plans in duplicate for Building on
plots no 15 and plot no 16 Sheet D-1
Jail Quarter showing deviations in eleva-
tion from the sanctioned plan.

I have the honour to be
Sir

Your Most Obedient Servant

D. H. Daruvala B.E.

Architect.

Mr. Daruvala

Show approve plan

Nathu

26/2

completed with
27/2

26/2

PROPOSED DESIGN
FOR
BUILDING ON PLOT No 13 SHEET D-1



SECTION ON A.B.

JAIL QUARTER

SCALE 8 FT = AN INCH


SITE PLAN

SCALE 40 FT = AN INCH

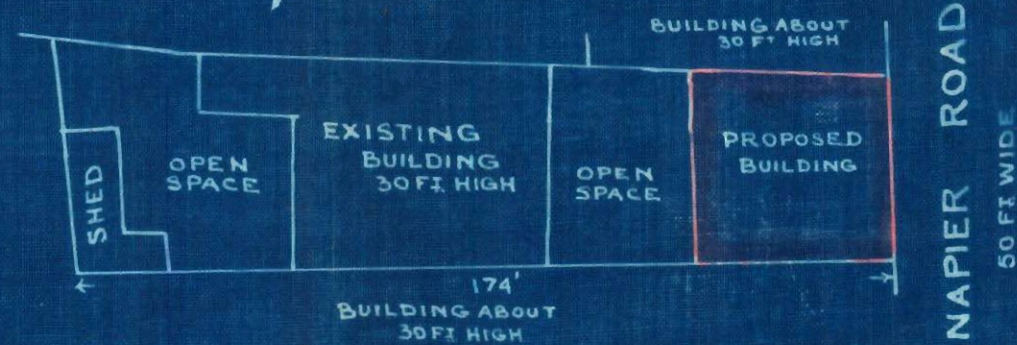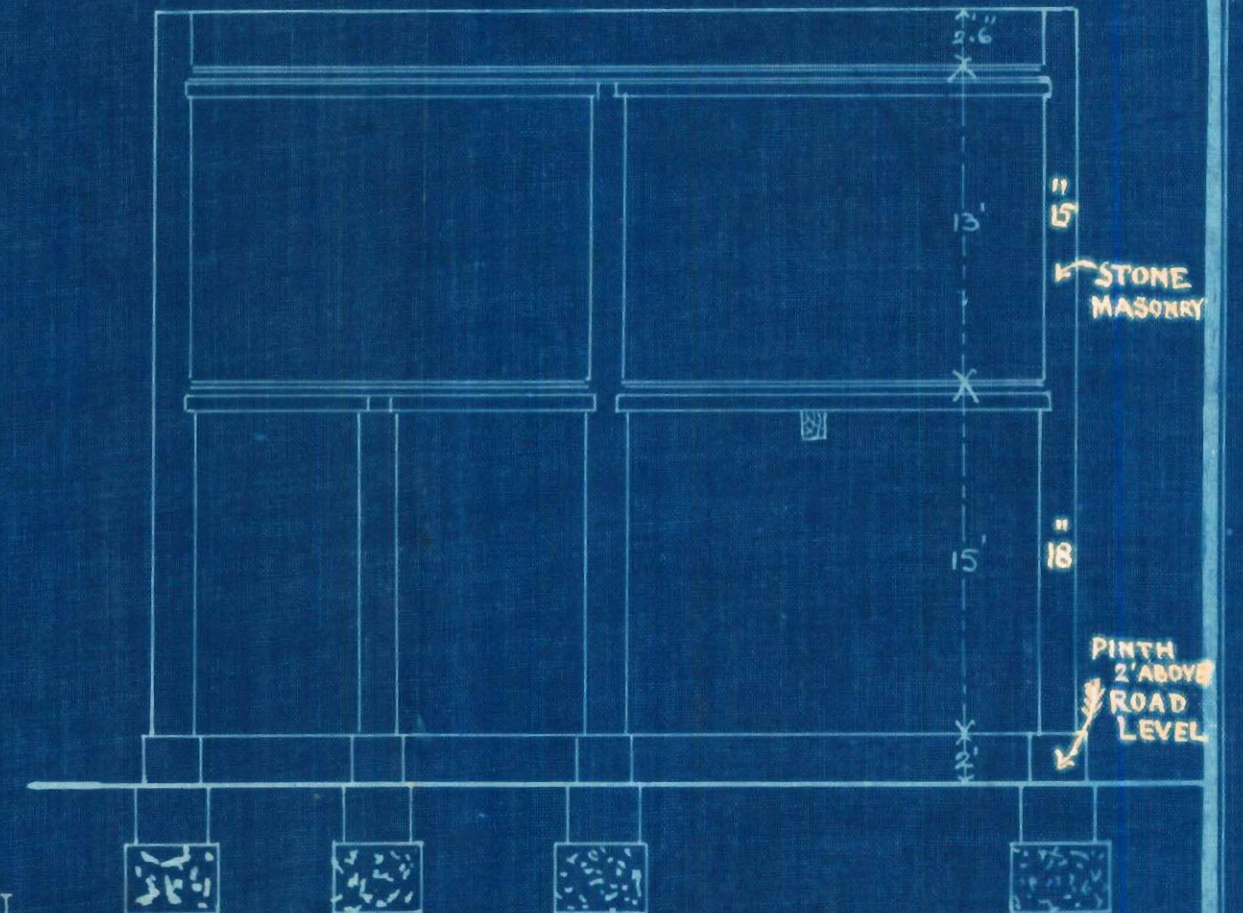

ELEVATION

SCALE 4 FT = AN INCH

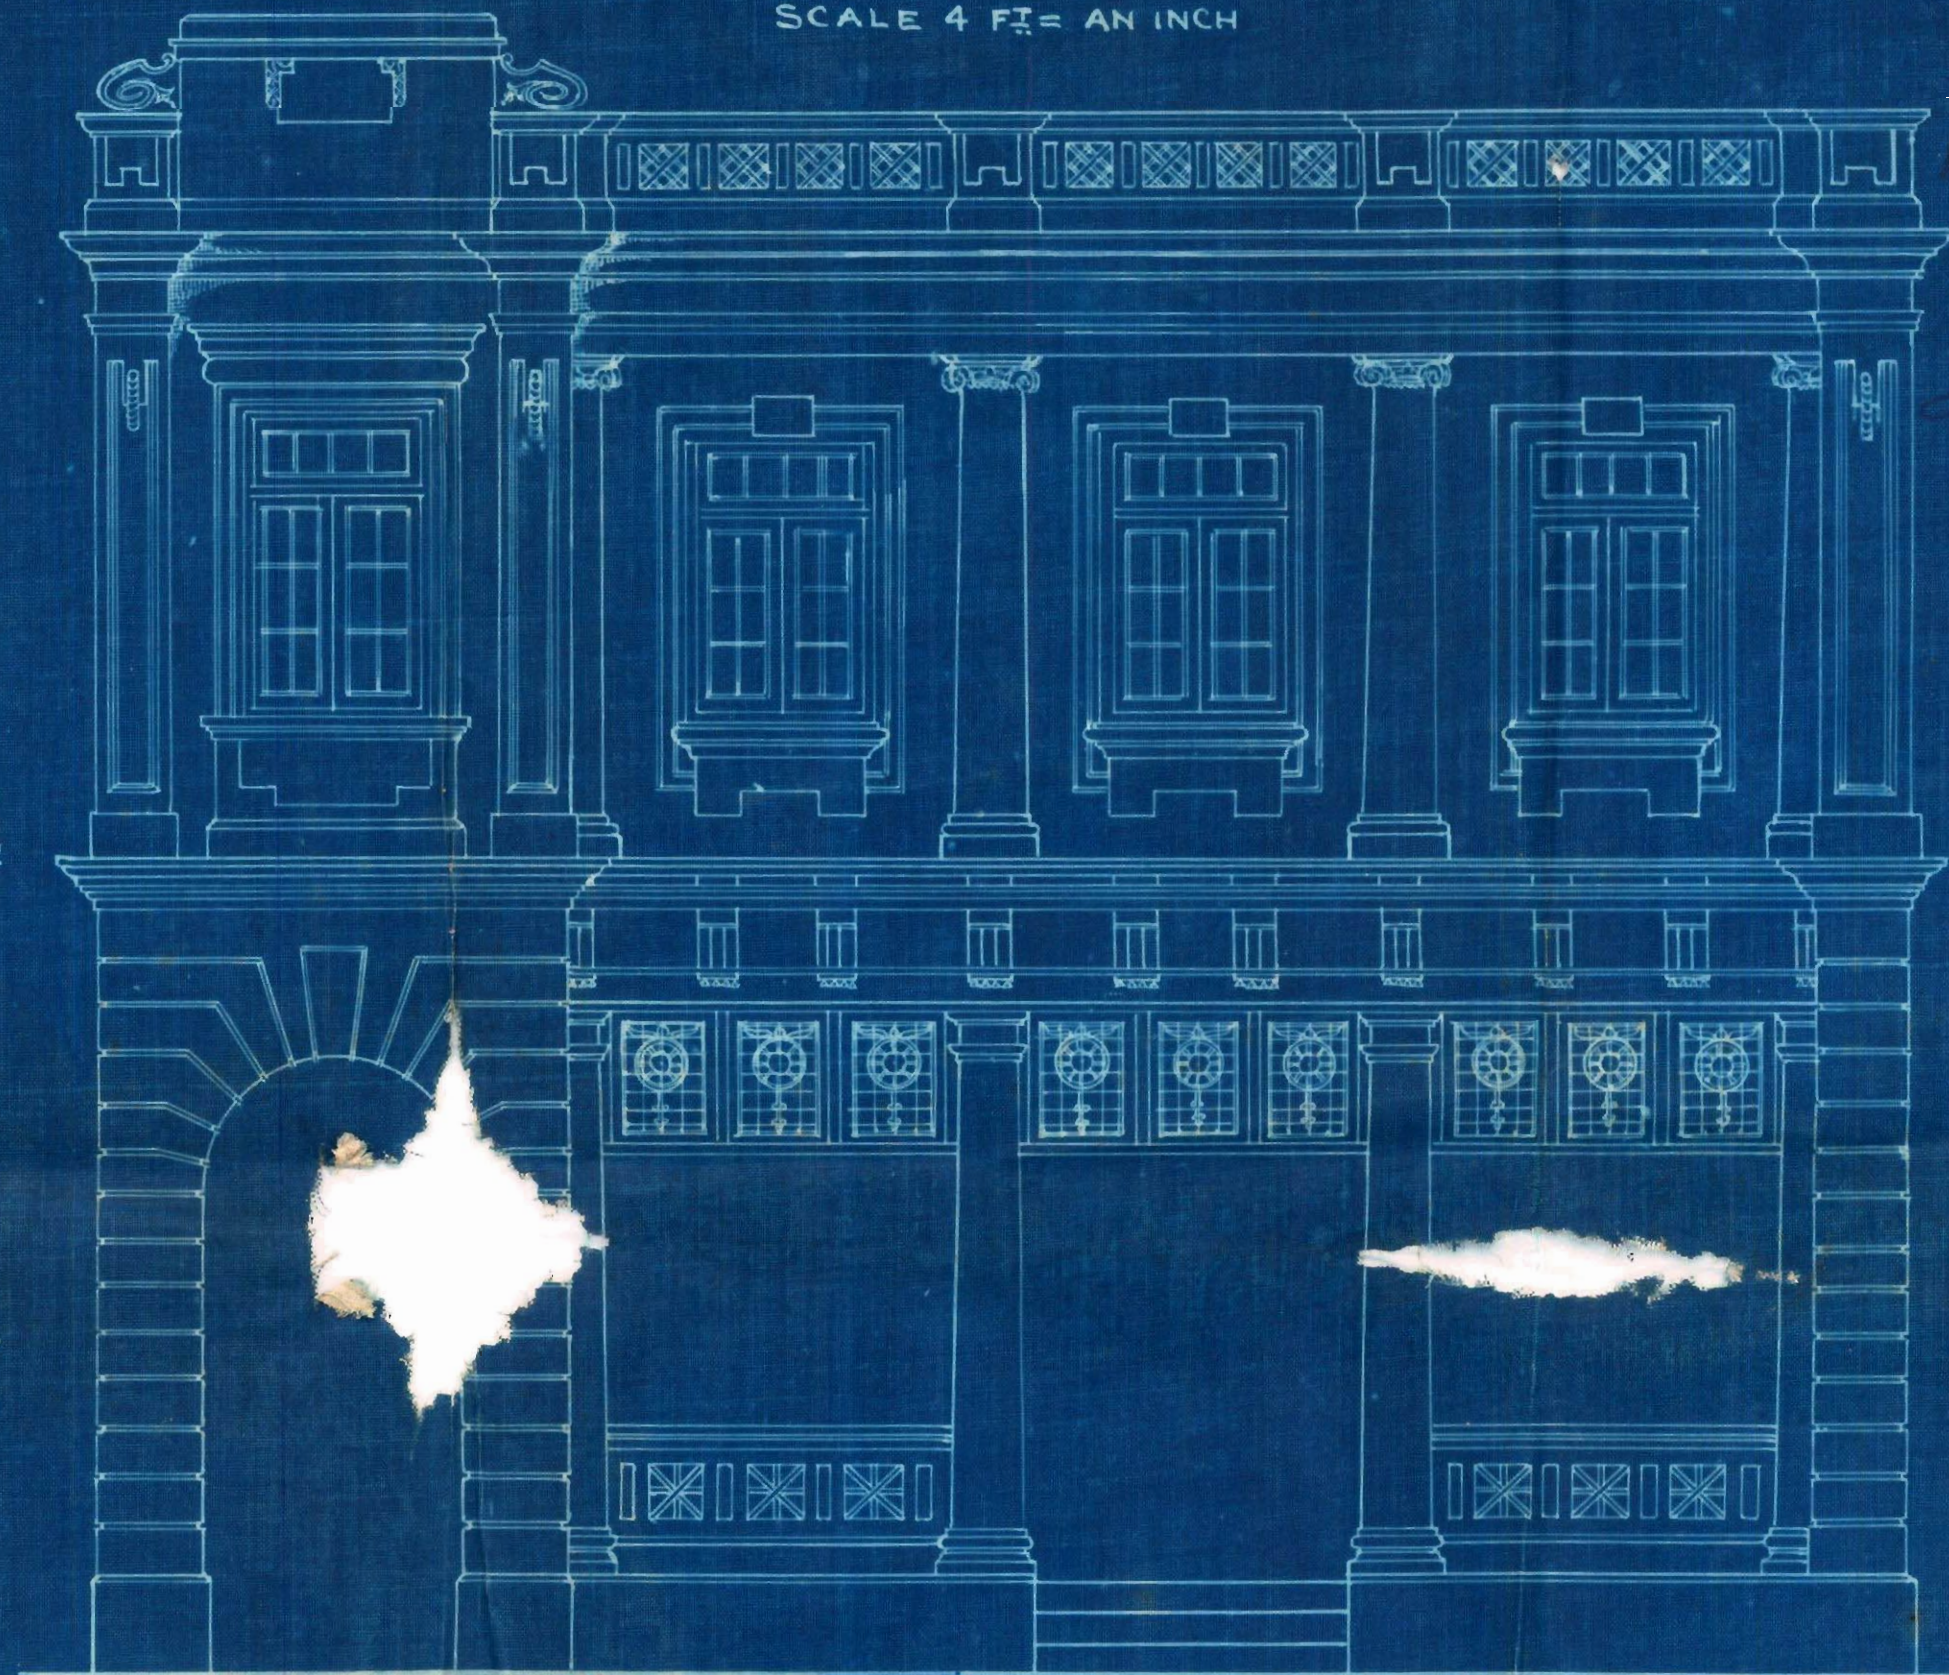


AMENDED PLAN.
APPROVED


J. G. K. K. K.

Engineer
Karachi Municipality

M. H. D. M. S.
MISTRI & BHEDWAR
B.A. S. S.
ARCHITECTS & CIVIL ENGINEERS

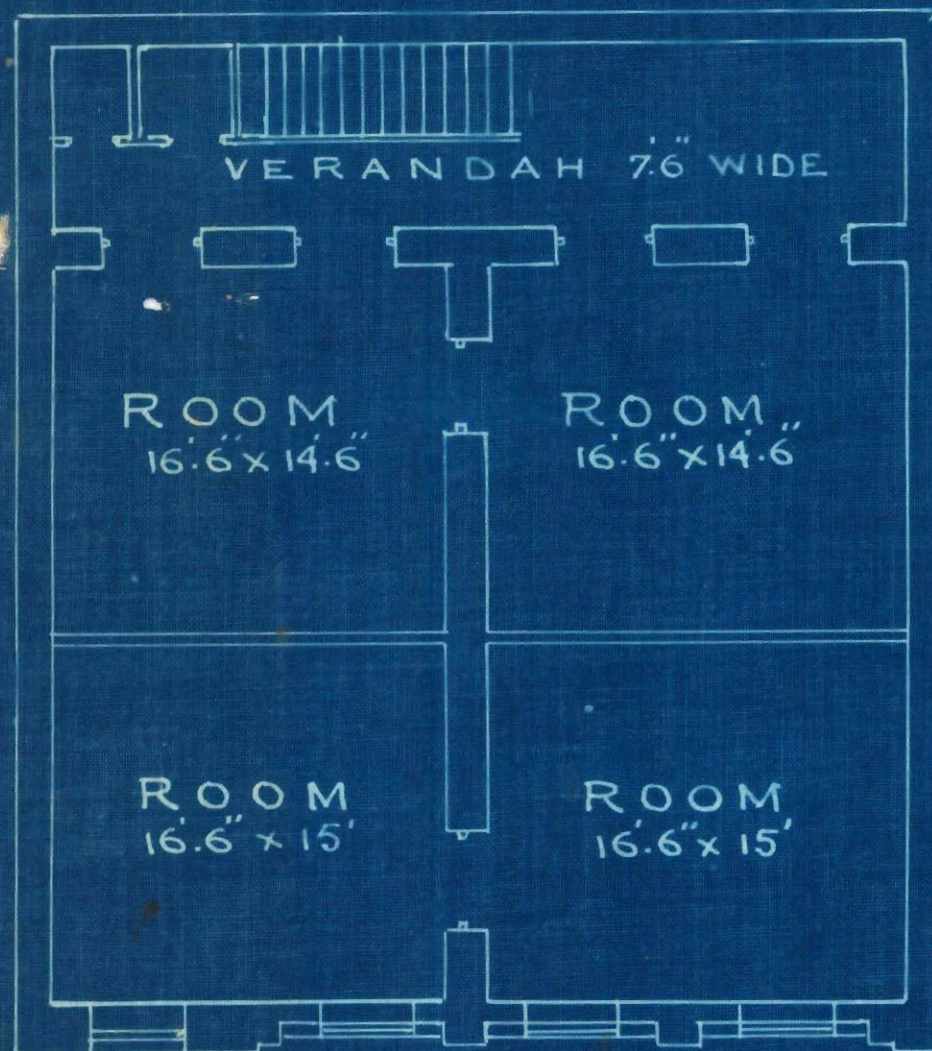


FIRST FLOOR PLAN

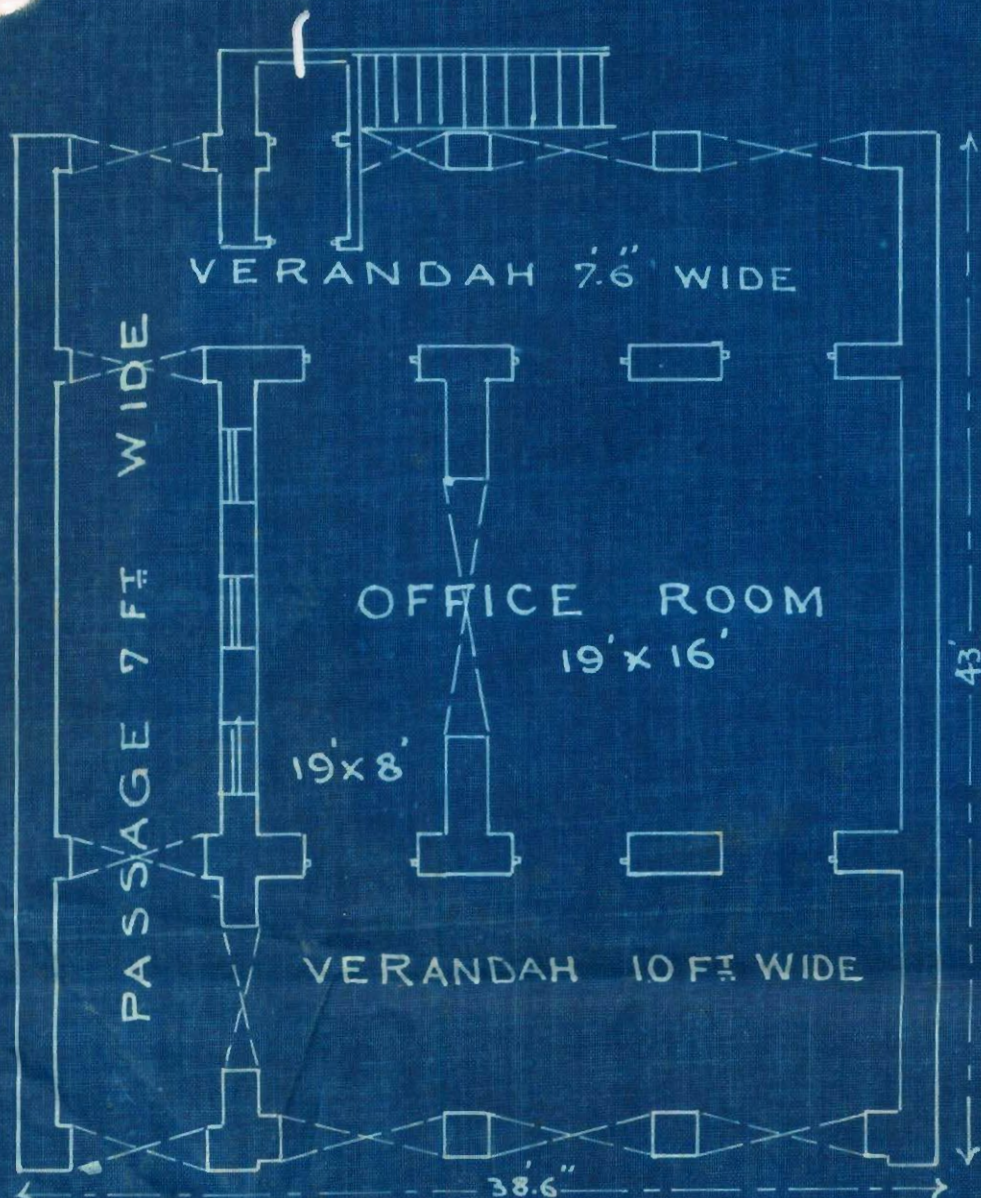


GROUND FLOOR PLAN

PROPOSED DESIGN
FOR
BUILDING ON PLOT No 16 SHEET D-1
JAIL QUARTER
SCALE 8 FT = AN INCH

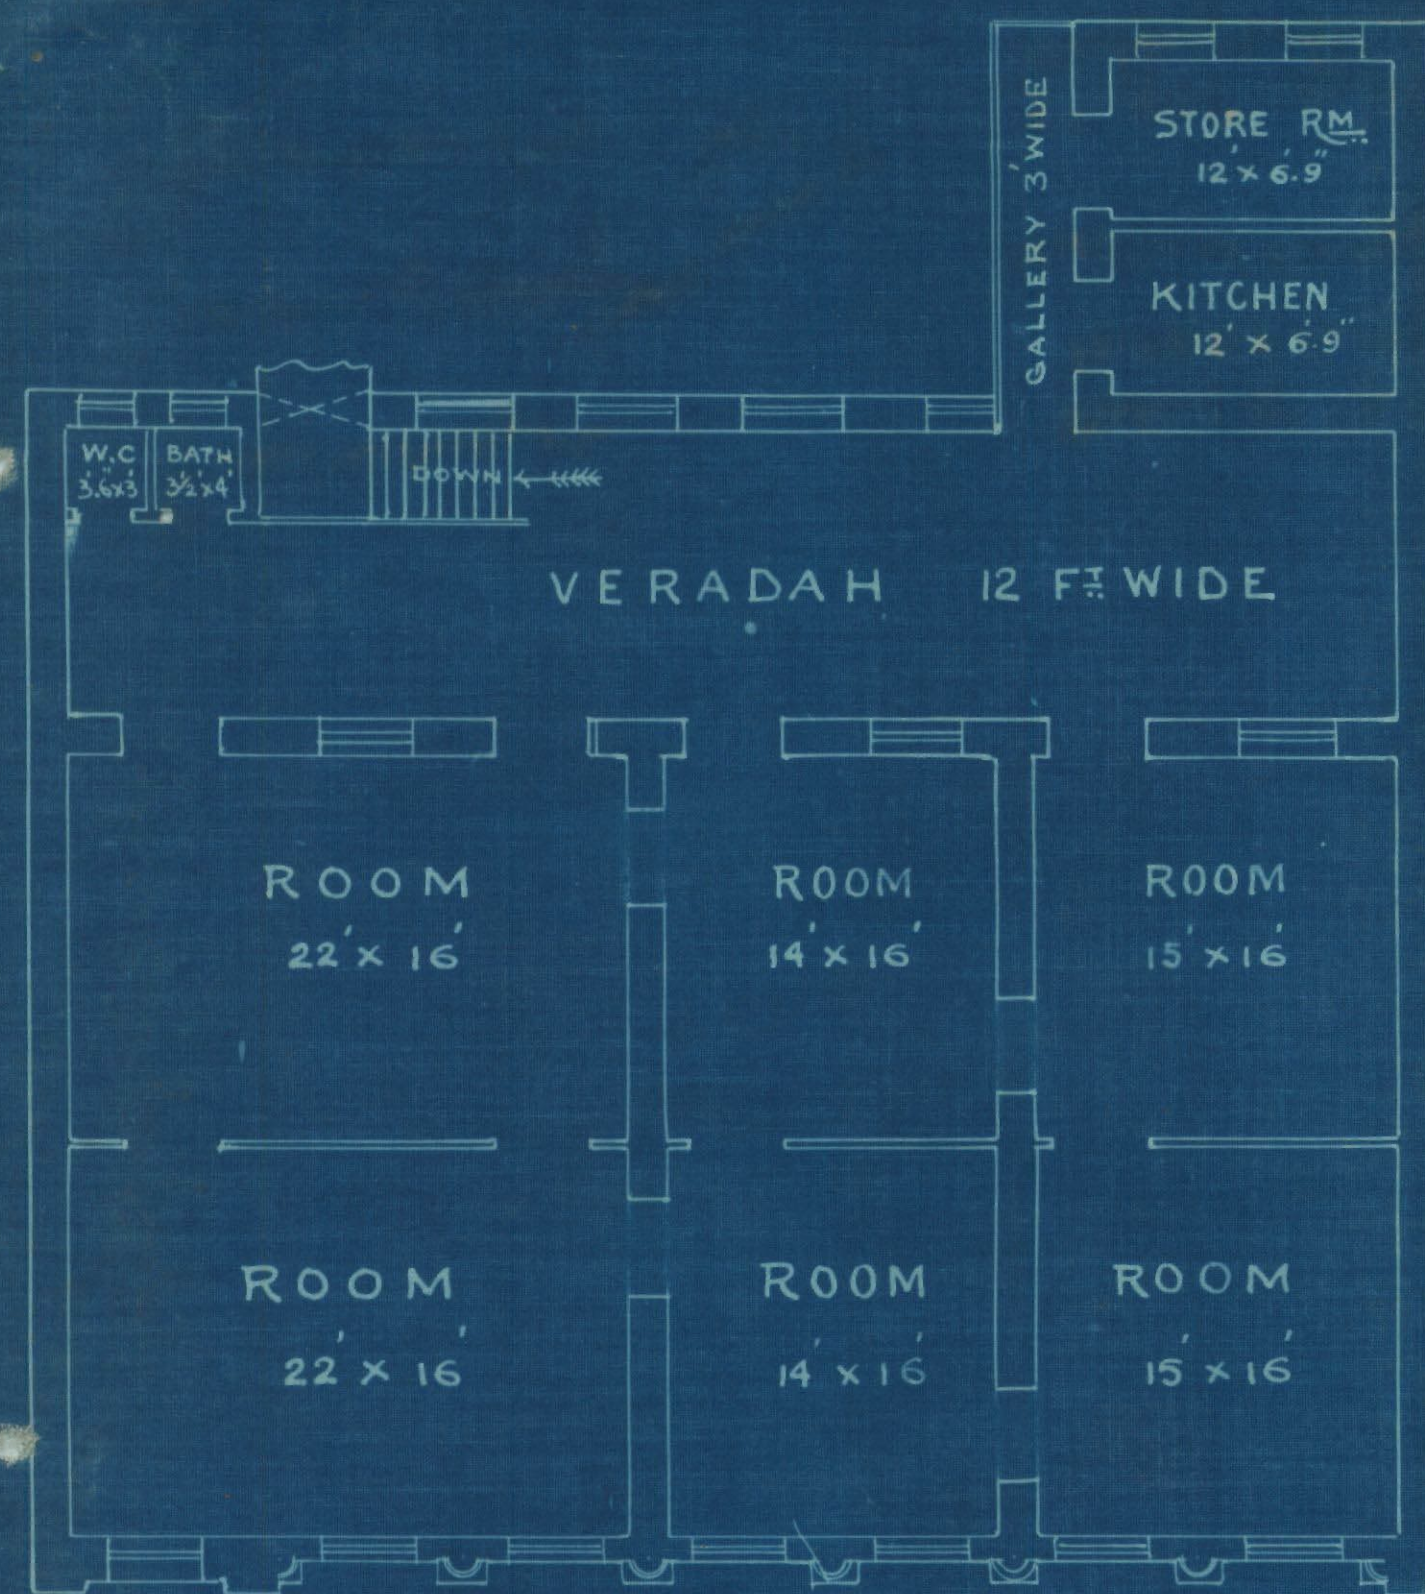


FIRST FLOOR PLAN

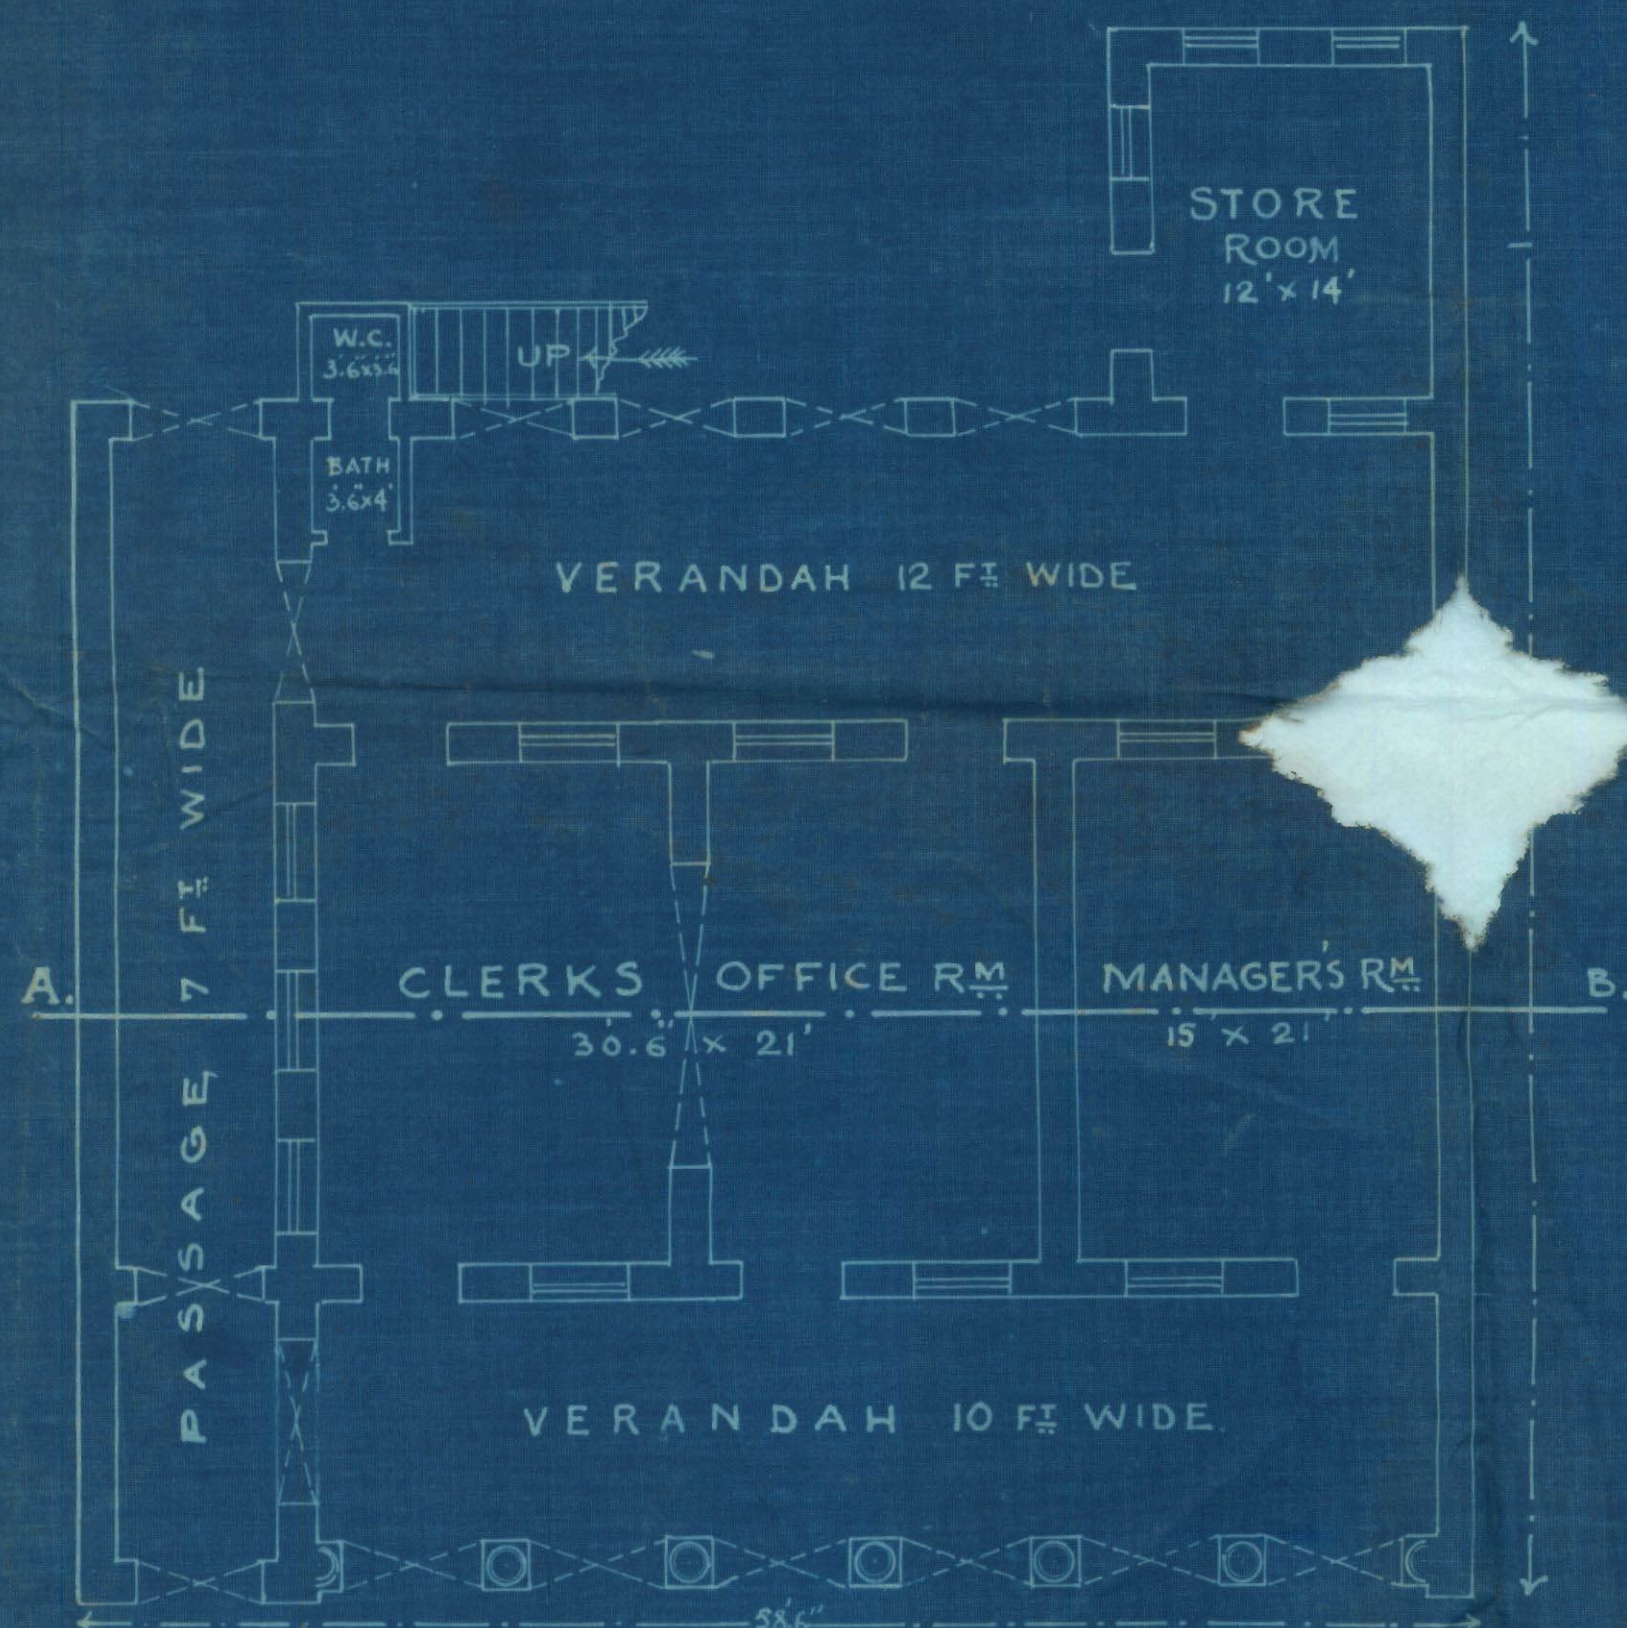

GROUND FLOOR PLAN

SECTION ON A.B.

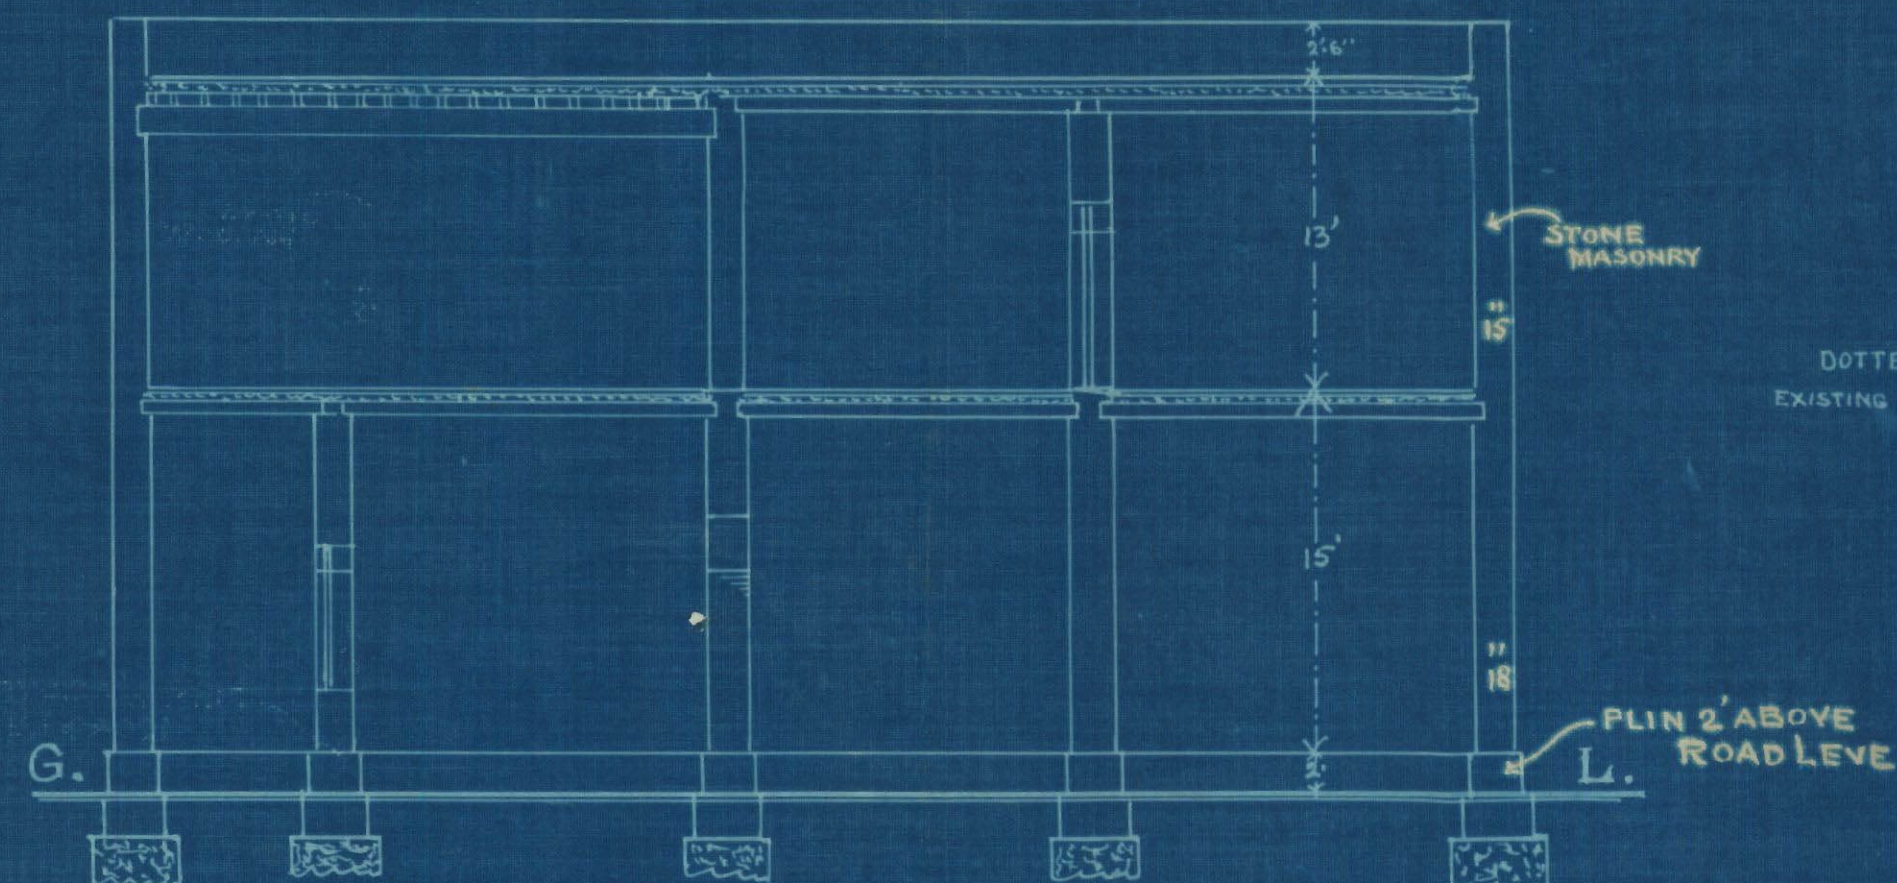


SITE PLAN
SCALE 40 FT = AN INCH



AMENDED PLAN
 APPROVED

Santhosh K. K.

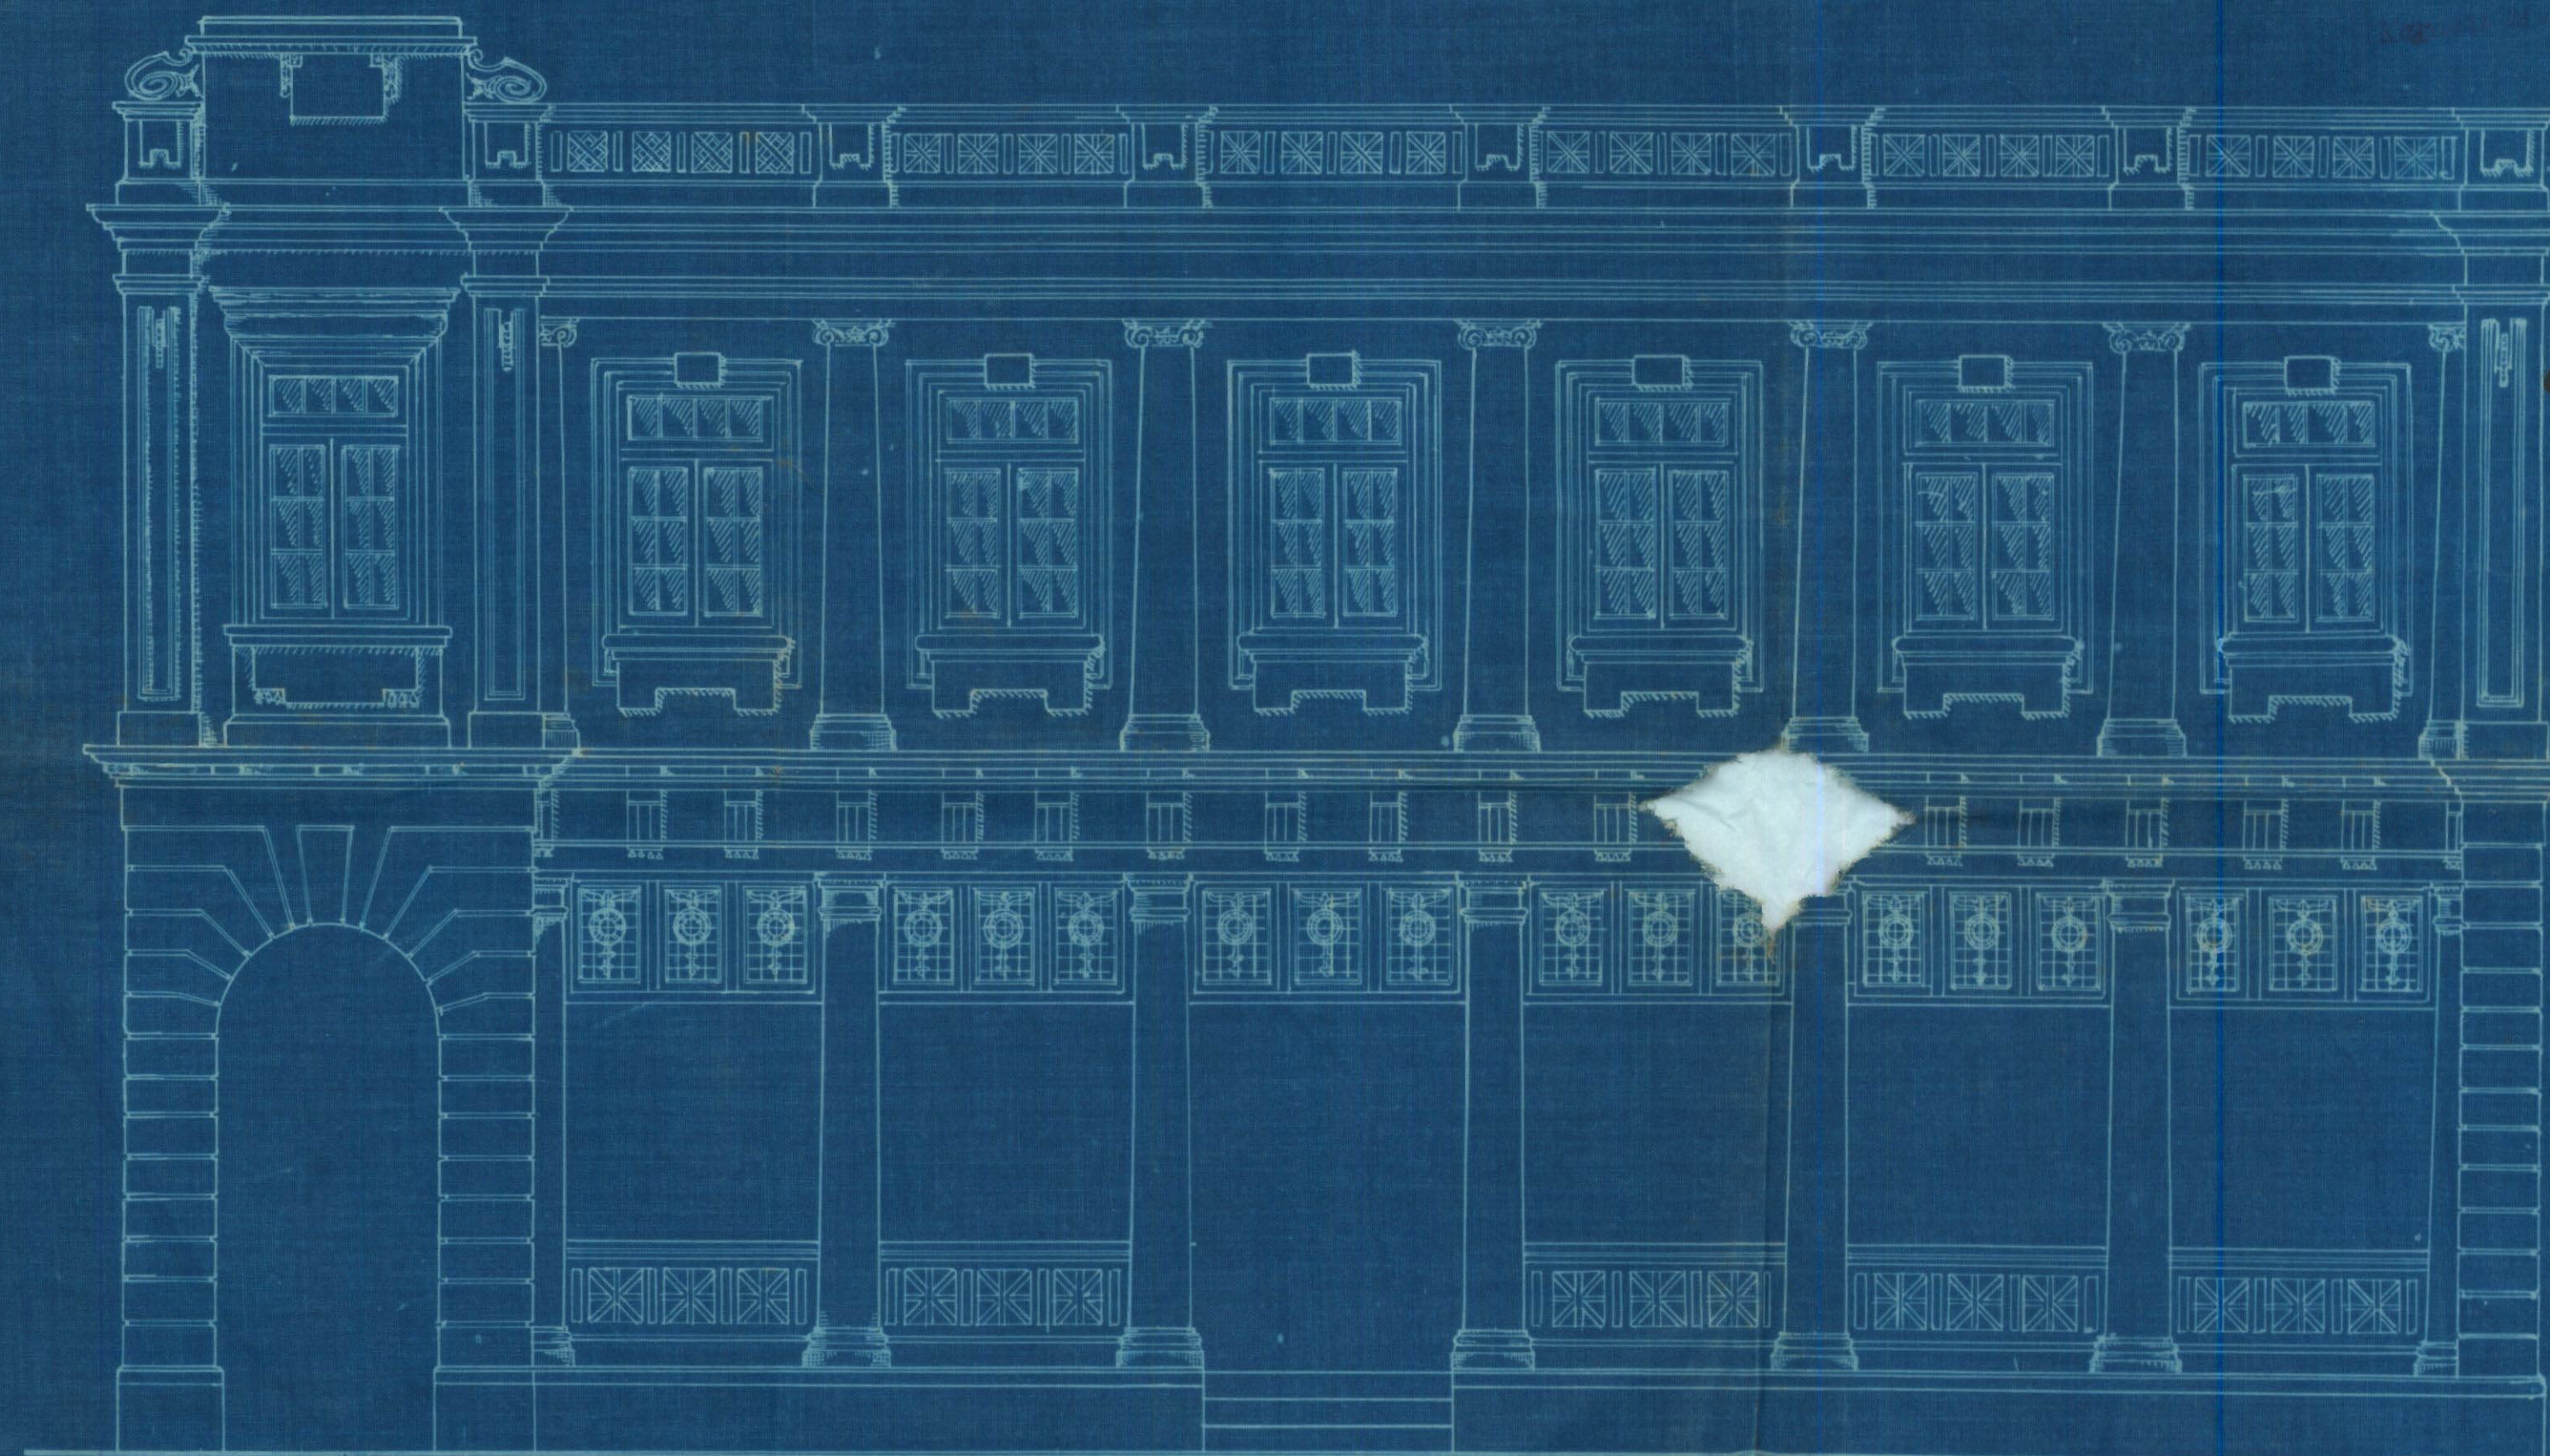

ELEVATION
SCALE 4 FT = AN INCH

S. S. Dhanu
 MISTRI & DHEDWAR
 ARCHITECTS & CIVIL ENGINEERS