


DRAWING NO 896

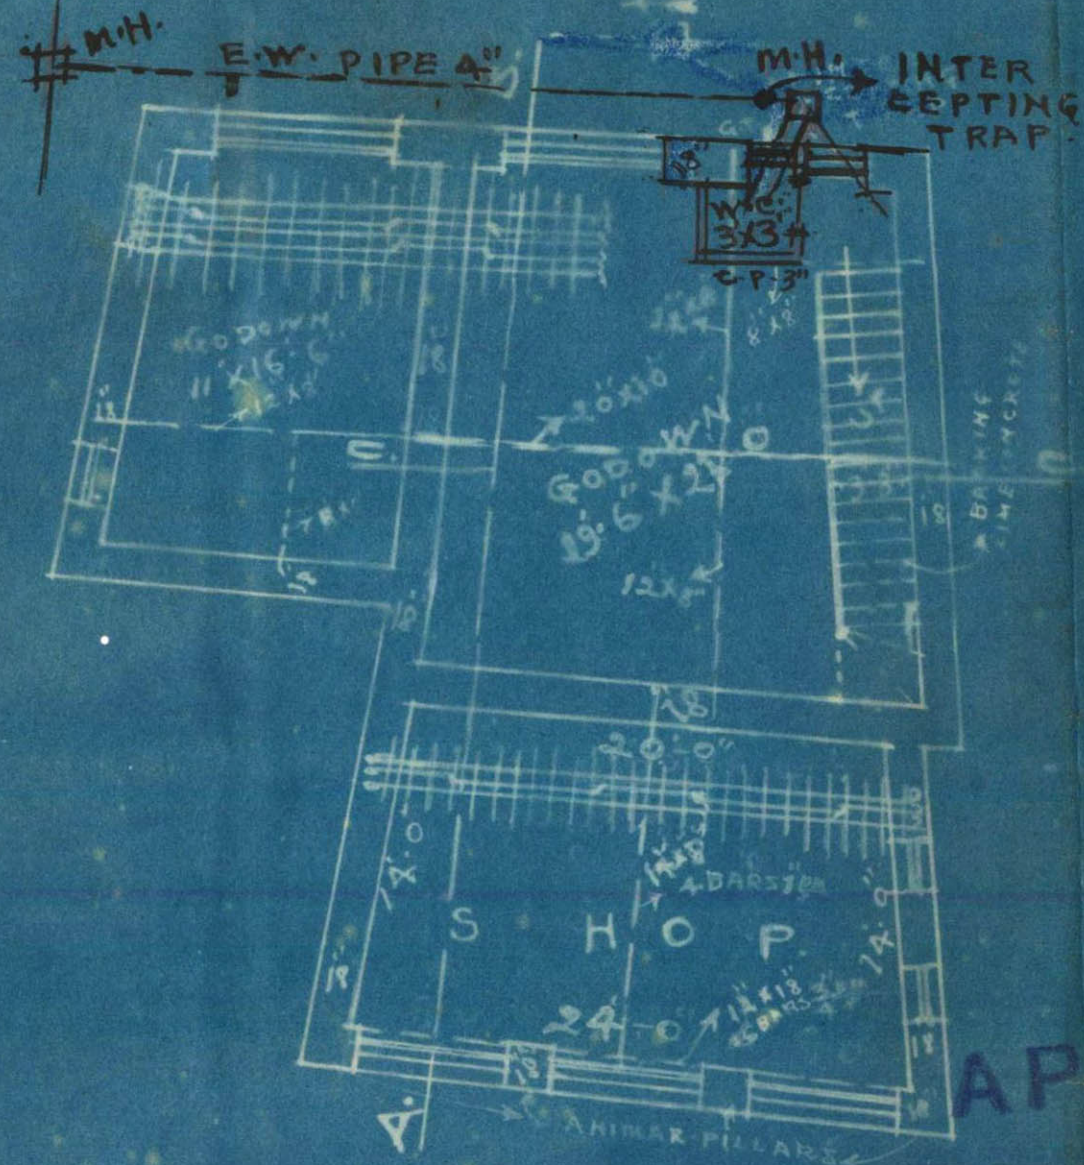


GROUND PLAN



Approved.
B. Sc., A. M. Ints.
Land Manager & Architect

FIRST & 2ND FLOOR PLAN


PLAN OF PROPOSED BUILDING
ON PLOT NO 30 SHEET NO N.P.1.
NAPIER QUARTER
SCALE 8'-1" INCH

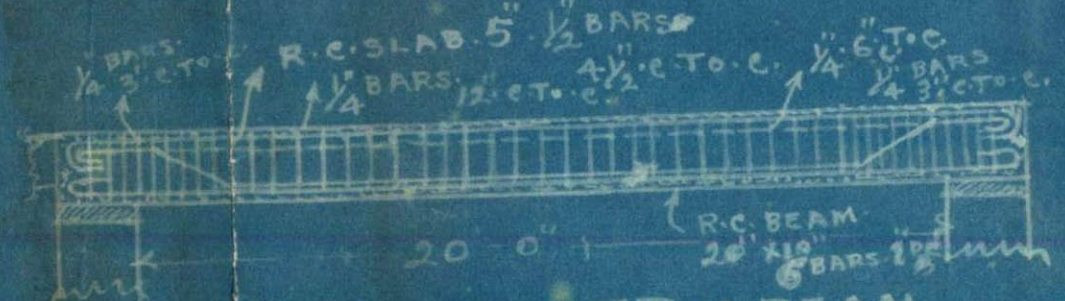


DETAILS OF R.C. BEAM
ELEVATION & SECTION
ON C.C.
SCALE 4'-1" INCH

Note:


BLOCK PLAN
SCALE 20'-1" INCH

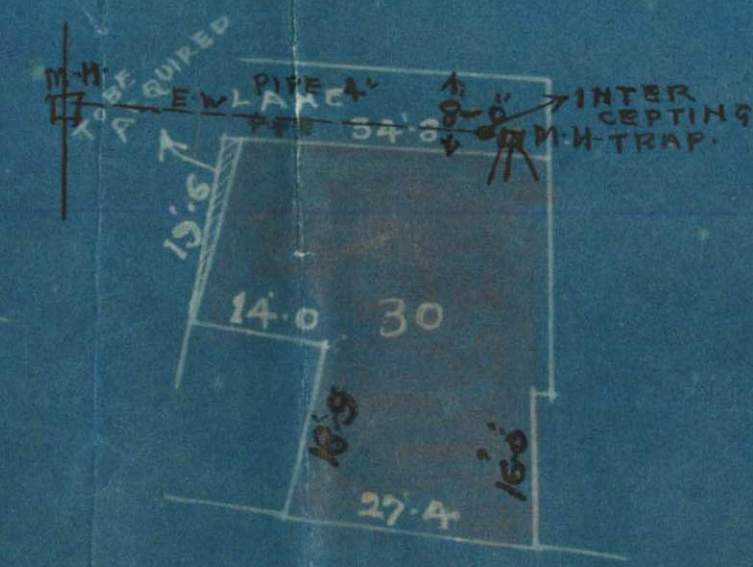

DARIYAL STREET
20' WIDE

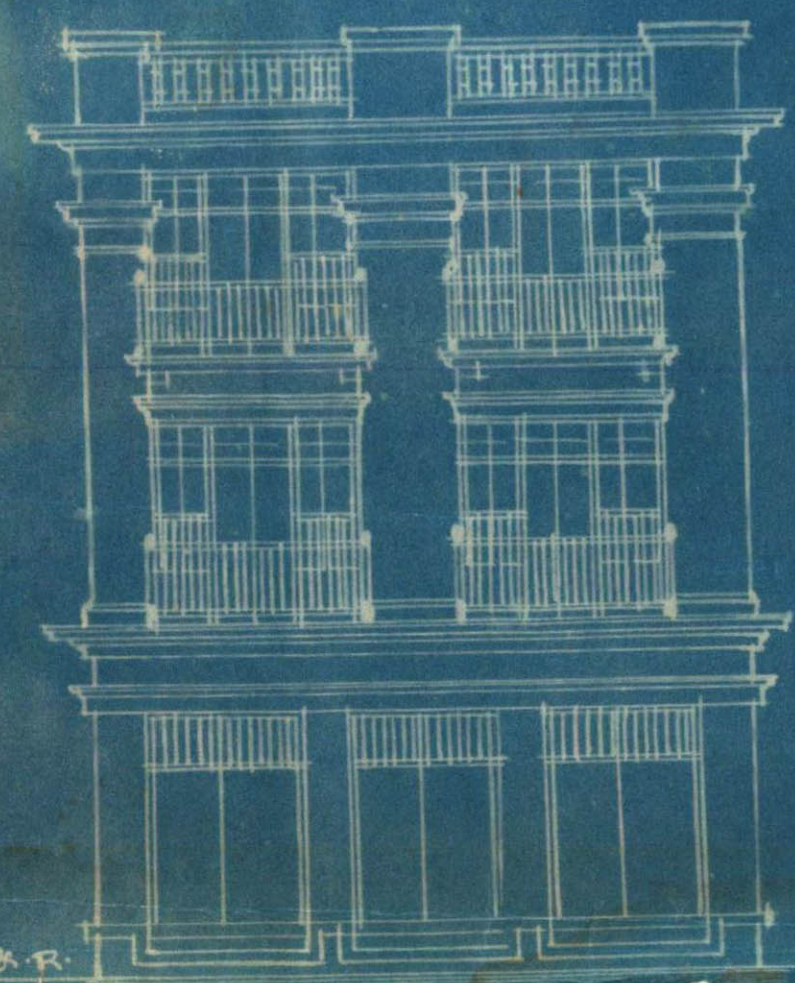

FRONT ELEVATION

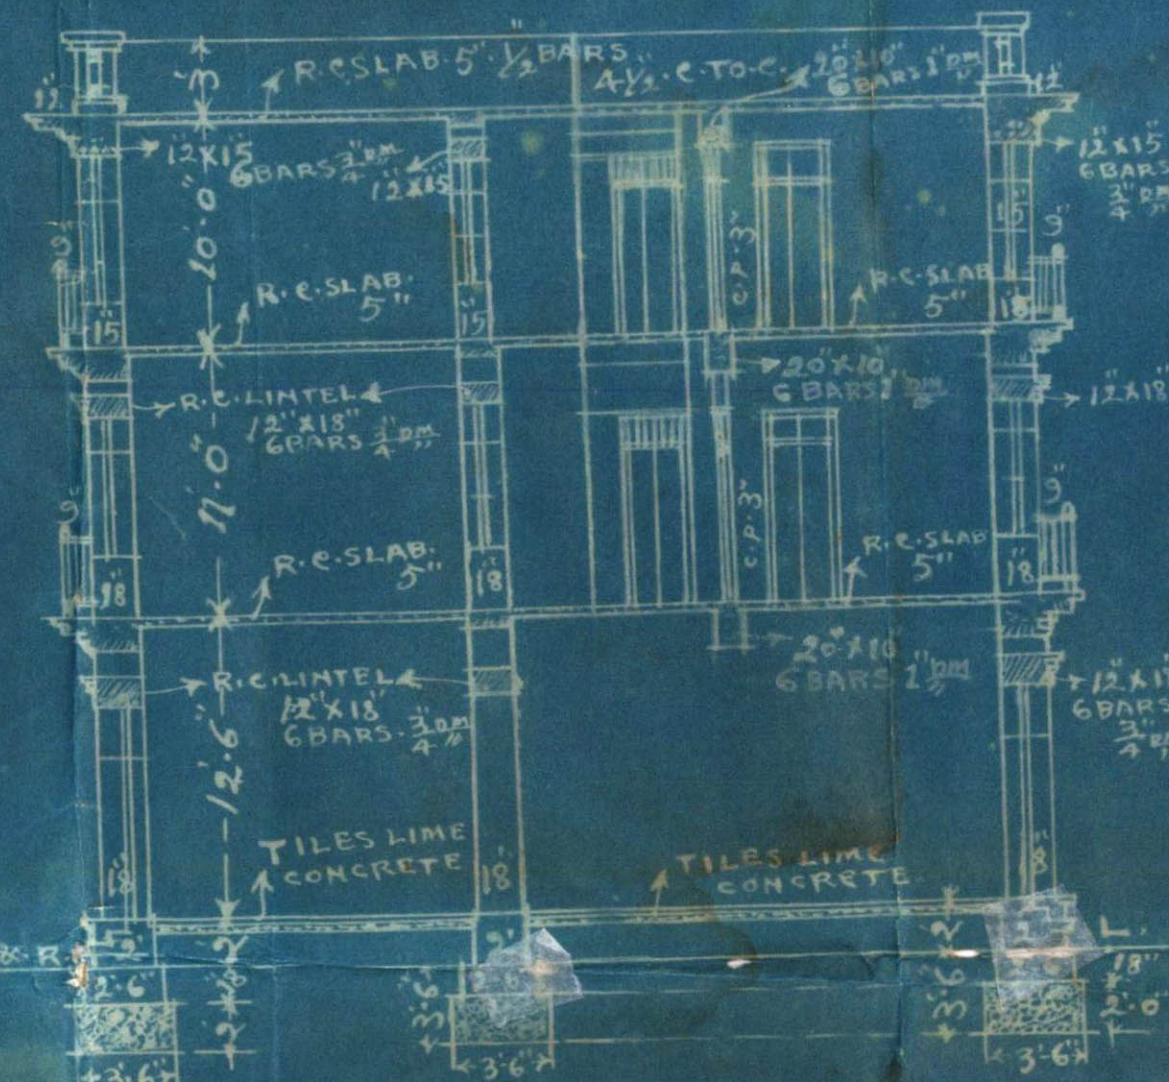

SECTION ON A.B.

Devi Kishor Das
per Bagomal Dikran

FORM A.

NOTICE UNDER SCHEDULE VI CHAPTER XI, RULE 2 (I) OF
THE CITY OF KARACHI MUNICIPAL ACT 1933.Karachi 4th Feb 1935

Date of delivery at Municipal Office

To,

THE CHIEF OFFICER,

MUNICIPAL CORPORATION,

Dear Sir,

KARACHI.

Pursuant to the provision of Schedule VI, Chapter XI, Rule (1) of the City of Karachi Municipal Act 1933, I hereby give you notice that I intend within the meaning of that rule to erect a building on plot No. 30 Survey Sheet NP-1 Situated in Durgalal street Napier Quarter as per Ground plan, Elevation and Section sent herewith in quadruplicate.

The said building will be of the following description, _____

Residences & shops.

It is intended for the purpose of _____

Residence

†Specification of the work will be as follows:--

*I also submit herewith a certificate from the Electrical Inspector to Government as required under Rule 92 (3) of the Indian Electricity rules.

I further beg to inform that the name of the person whom I intend to employ to supervise the erection of the said building is Devkishindas

I hereby under take to abide by the City of Karachi Municipal Act 1933, and all rules and bye-laws framed pursuant to the Act.

Yours faithfully,

Signature of the owner _____

Address of the owner _____

ie Kishindas Paramand
her Paramand Utsomal

†See on the reverse.

*This line to be struck off if there is no electric line passing by the plot.

২২

2

Nature of soil in foundation

Nature of masonry in foundation

do Plinth

do Superstructure *W*

Kind woodwork in trusses, post, etc.

Kind of Roof

Kind of Floor

Method of Draining Sullage Water

—:O:—

NOTE:—Specification and nature of work should be given against items of work mentioned above.

Karachi

To,

The Chief Officer,

Municipal Corporation.

Sir,

Karachi,

With reference to the notice under Schedule VI, Chapter XI, Rule (2) 1 of the City of Karachi Municipal Act 1933, submitted to you by Mr.

for the building

I beg to inform you that I have agreed to supervise the erection of building work mentioned therein.

I beg to remain,

Sir

Your most obedient Servant.

Am 15. 10. 1885

Licensed Surveyor.

S. S. (A) } 1000-10-34



Karachi Municipal Corporation.

NOTES SECTION.

Building Department.

Case No. R/C 8/35

Applicant's Name Richard ParmandArchitect's Name Heurich

EXTRACT FROM THE LAND REGISTER.

New plot No. 30 Sheet No. N.P-1Old plot No. _____ Sheet No. _____ } Napier Quarter.

Whether under Govt. or Municipal Control ...	
Registered Holder of plot	
Area.	Government ...
	Municipal ...
	Total ...
Title and period of lease	
Form of lease ..	
Any Special conditions of lease ...	
Remarks, ... <u>Date of tendering 4 3/35</u>	

The above application with plans is forwarded with compliments to the Health Officer for favour of remarks, & returned as early as possible—

Date of despatch 5/2/1935

for Land Manager and Architect.

HEALTH OFFICER'S REMARKS.

no objection

Date

Health Officer.

{ 0.29/35 }
30, N.P-1

3-2



Heritage

KMR.CDD.NaQ.1935.01

A copy of plan is herewith forwarded to Engineer for favour of remarks and return as early as possible.

Date of despatch 7/2/35 NAB
for Land Manager & Architect.

ENGINEER'S REMARKS.

No objection

NAB

Date _____ ENGINEER.

LAND SURVEYOR'S REPORT.

- (1) Does the plot come under Alignment? yes
- (2) If so, is the street line correctly shown. yes
- (3) Does the plot come under the T. P. Scheme? -
- (4) If so, is the plot shown as finally re-constituted. _____
- (5) Is there any encroachment? no
- (6) If so, state the nature and No. of sq. yds. _____
- (7) Is the plot subject to any conditions of previous sub-division and Amalgamation? _____
- (8) If so, state the conditions. _____
- (9) Is the street width correctly shown? yes

Date 14-2-35

RMPunekar
Head Draftsman.

NAB

Date _____

Land Surveyor



3-3

C-28/35

3

Plot No. 30

Sheet No. N.P-1 Mapas Qr.

BUILDING SURVEYOR'S REPORT.

No objection

L. 13/12

Date _____

Building Surveyor

Remarks of LAND MANAGER AND ARCHITECT

Man approved

L. 26/12



No objection

No objection

Date _____

Land Manager and Architect,

AMENDED PLAN OF BUILDING ON
PLOT N^o 30 SHEET N^o N. P. 1.
NAPIER QUARTER
SCALE 8' = 1" INCH

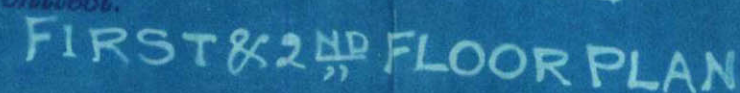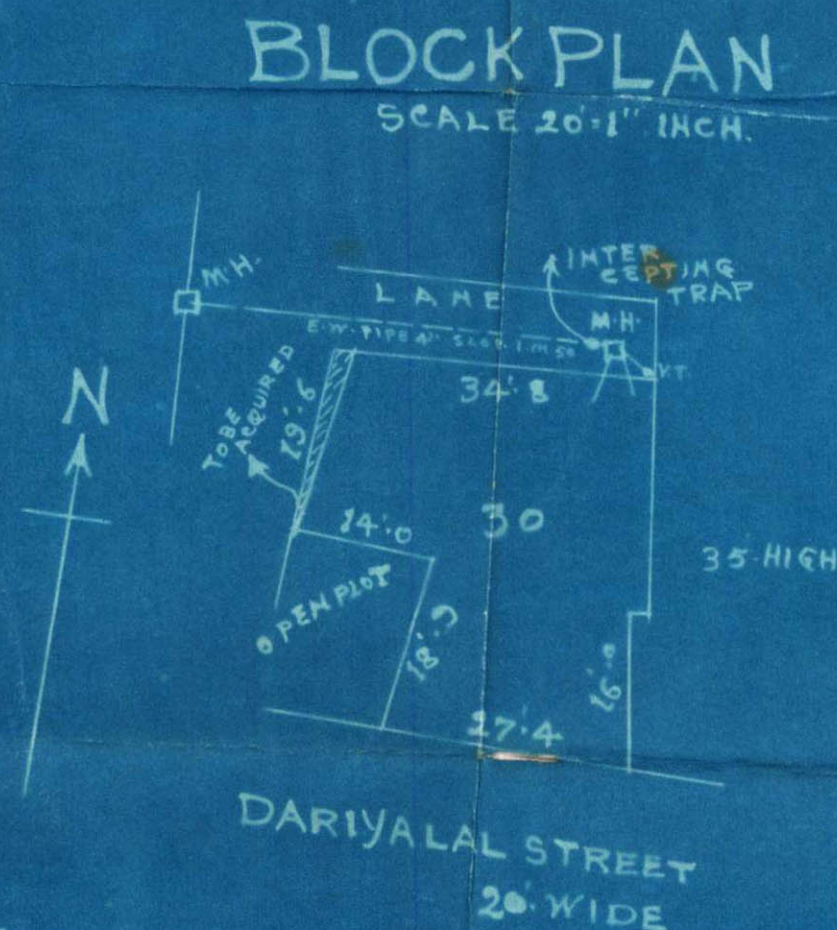

Office Telephone Nos. 1140 & 1141.

Residence " " 199.

KUMBERALI BHALEDINO,
L. C. E.,

LAND MANAGER & ARCHITECT



Heritage

KMR.CDD.NaQ.1935.01

MUNICIPAL CORPORATION,
KARACHI.

Reference No. B. S. C. 29/35

2 - MAR 1935

To,

Mr. Kishinchand Parmar and

c/o Mr. Devkishindas (Architect)

KARACHI.

RE: Plot No. 30 Sheet No. N.P.1, Napier Quarter

Dear Sir,

With reference to your application dated 4.2.35
with amended plans for the building on the above plot a copy of the plan
duly signed and approved is returned herewith.

Yours faithfully,

Lambaree Bhaleedino

1/3

Land Manager & Architect.



NOTICE OF COMPLETION UNDER SECTION 187 (1) OF THE
CITY OF KARACHI MUNICIPAL ACT. 1933.

Karachi, 10th May 1935

To,

The Chief Officer,

Karachi Municipal Corporation,

DEAR SIR,

I hereby inform you that my following building and drainage
work (insert full particulars of the work) Ground & 2 upper
Floors - R.C.C. walls on plots no 30
NP-1 - Napier Q2

has been completed and the certificate of completion signed by the Licensed
Surveyor, who supervised the work, is submitted here-below.

Yours faithfully,

Kishin Das
Kishin Das Param and
Owner,

Address

Completion Certificate

TO BE SUBMITTED BY LICENSED SURVEYOR

BUILDING AND DRAINAGE COMPLETION CERTIFICATE.

I do hereby certify that the following building and drainage work
(insert full particulars of the work) Ground Floor & 2
upper Floors on plots no 30 NP-1
Napier Q2

has been supervised by me and has been completed to my satisfaction, that the
workmanship and the materials used are good; and that no provision of the act
or the Bye-laws and no requisition made, condition prescribed, or order issued
thereunder has been transgressed in the course of the work

Signed.

Ben Kishin Das. 2

Dated

10th May 1935

Pl. put up comp. report forms.
Rue.
22/5



187 (1) OF THE
ACT. 1933.

in, 10th. May 1935

oration,

info that my following building and drainage
rticulars of the work) ground & two upper floors
on plot No: 30, N.P.1 Napier gr:

and the certificate of completion signed by the Licensed
Surveyor, who supervised the work, is submitted here-below.

Yours faithfully,

(sd) Kishinchand Parmanand
Owner,

Address

—: o :—

Reference No. B. S. C. 29/35

Municipal Office,

Karachi, 10.5.35

1. Copy forwarded to the Assessor, Karachi Municipal Corpora
information. The above notice of completion was received on _____
2. Copy forwarded to the Superintendent of Machinery, Karac
cipal Corporation to communicate direct to the owner if there is any
to occupy the building and to send copy of his objection to the under.
3. Copy to the Land Surveyor, Karachi Municipal Corporation to
action at once if there is any encroachment on Municipal Land.

Wor

For Land Manager & Architect,
Karachi Municipal Corp

MUNICIPAL CORPORATION
KARACHI.

Office Telephone Nos, 1140 & 1141.
Post Office " " 199.
KUMBERALI BHALEDINO,
L. C. E.
LAND MANAGER & ARCHITECT

31 MAY 1934

REF. No. B. S. P. 169/34

MEMO :—

Re : Plot No. 30 Street NP 1 Napier.

Plan for building

on the above plot submitted by Mr. Kishindas Permanand

have been approved the Municipal Corporation, Karachi.

Kumberali Bhaledino

Land Manager & Architect.

Copy forwarded to :—

1. Health Officer.
2. Supdt., of Machinery.
3. Assessor.
4. Building Surveyor.
5. Land Surveyor,
6. Enquiry Officer.

for information and necessary action.