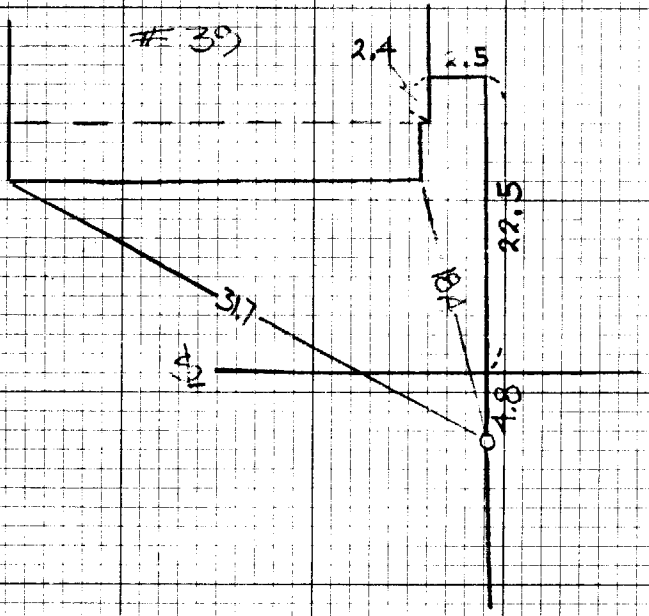

#39
2,4
1,5
22,5
3,7
4,2
4,8