not to be used to define boundaries

scale 1:200
METRES


Survey Certificate
for

LOT 2 SECTION 6 AND 7 TP2
NWD PLAN BCP 20892

38.000

CIVIC ADDRESS :
~~5589~~ 124 STREET
SURREY ~~B.C.~~
5598

ELEVATION ON
CURB WALL
57.09m

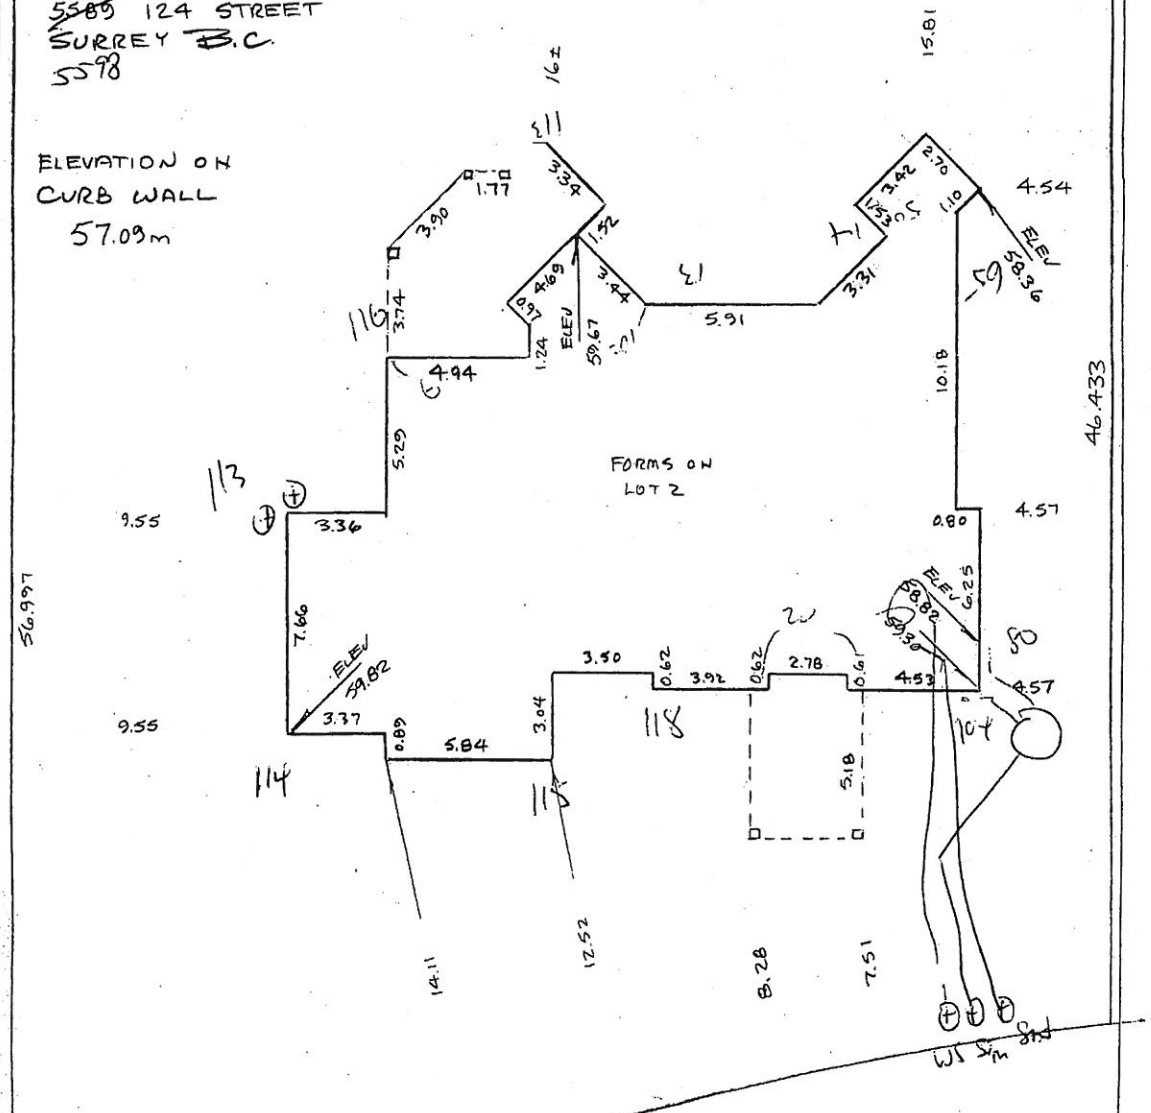

© C. James B.C.L.S. 2006

Christopher J. James
British Columbia Land Surveyor
2822 Gordon Avenue
Surrey B.C. V4A 3J4
604-535-3261

certified correct

B.C.L.S.

this 12 day of OCTOBER 2006

this document is not valid unless originally signed and sealed

file # 5757