Interior Health
Health Protection

Sewerage System
Letter of Certification

Tax Assessment Roll #: 320 03068.030 Date: 25/09/14
(Day/Month/Year)

To: Interior Health Authority

Re: Sewerage system at: 4880 56 Street NW Salmon Arm
Street Address or General Location

Lot 7 Sec 29 TP 20 R 10 W6M KDYD Plan Kap 85703 PID 026-348-377
Legal Description

Planner: Jason Meger #0145

Installer: Jason Meger #0145 Owner: David, Karen Cross

The construction of the proposed sewerage system on the above described property was completed on 25/09/14
(Day/Month/Year)

I, the undersigned, am an authorized person as defined in the *Sewerage System Regulation, BC Reg. 326/2004* and certify that:

1. the owner will be provided with
   - a copy of the sewerage system plans and specifications as they were built;
   - a maintenance plan for the sewerage system that is consistent with standard practice; and,
   - a copy of this letter of certification;
2. the sewerage system has been constructed in accordance with standard practice;
3. the sewerage system has been constructed substantially in accordance with the plans and specifications filed with the Health Authority;
4. the estimated daily domestic sewage flow through the sewerage system will be less than 22,700 litres; and,
5. if operated and maintained as set out in the maintenance plan, the sewerage system will not cause or contribute to a health hazard.

A plan of the sewerage system as it was built and a copy of the maintenance plan for the sewerage system have been appended to this letter.


AUTHORIZED PERSON'S SEAL	DATE LETTER OF CERTIFICATION ACCEPTED	DATE LETTER OF CERTIFICATION RECEIVDED BY NON HEALTH PROTECTION CLERK
ASTTBC JASON MEGER PL IN MP OW0145	RECEIVED IH/INTERIOR HEALTH VERNON HEALTH CENTRE SEP 25 2014	

White: Health Protection **Canary:** Owner **Pink:** Building Authority **Blue:** Authorized Person

820083 Dec 07

N

As Built
4880 56st NW
PID # 027-348-377

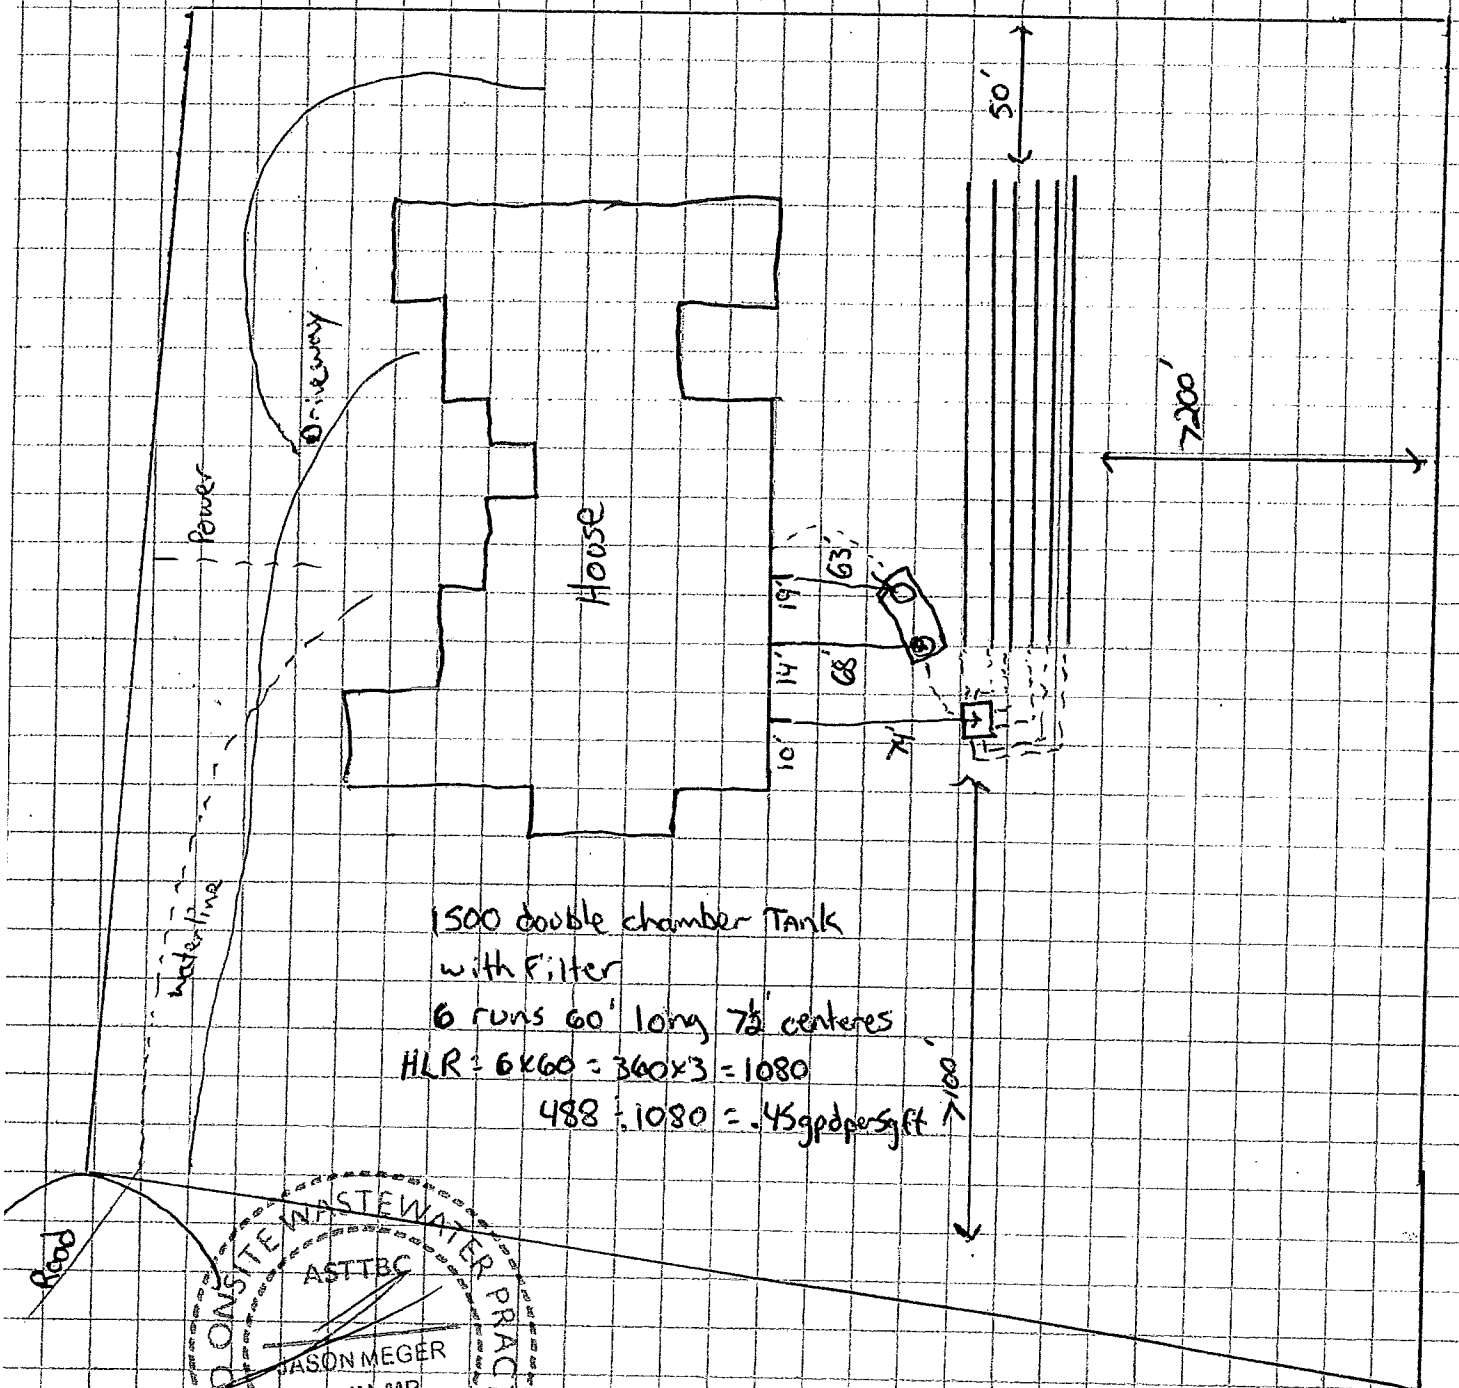

1500 double chamber Tank
with Filter
6 runs 60' long 7½' centeres
HLR ÷ 6x60 = 360x3 = 1080
488 ÷ 1080 = .45gpdpersqft

REGISTERED ONSITE WASTEWATER PRACTITIONER
ASTTBC
JASON MEGER
PL IN MP
QW0145

Cougar Claw Excavating

Septic System Maintenance Plan

- pump septic tank every 4 years (must be inspected by Certified Maintenance Provider)
- clean effluent filter yearly
- inspect distribution box yearly and make adjustments if needed
- all maintenance must be done by a registered onsite wastewater practitioner (Maintenance Provider)
- know where your septic system is, keep a map and maintain records
- practice water conservation - your system will last longer
- plant grass on your drain field rather than trees or shrubs
- divert roof, patio and driveway runoff away from the drain field
- keep sump pumps hillside runoff and foundation drains away from the system
- don't put non-degradables down sinks or toilets, such as cigarettes, diapers, hair, grease, cat litter, coffee grounds, etc.
- don't use septic tank additives or excessive amounts of bleach
- don't pour harmful chemicals down your drains
- don't stress the system with multiple laundry loads on one day
- don't discharge water softening devices into septic system
- don't park or drive on your drain field
- don't saturate your drain field with automatic sprinkling

Certified Maintenance Provider: Jason Meger ph (250) 309-2165

REGISTERED ONSITE WASTEWATER PRACTITIONER • ASTTBC • JASON MEGER PL IN MP OW0145

I, the homeowner, understand this maintenance plan and will follow it.

Name

Signature

Date