


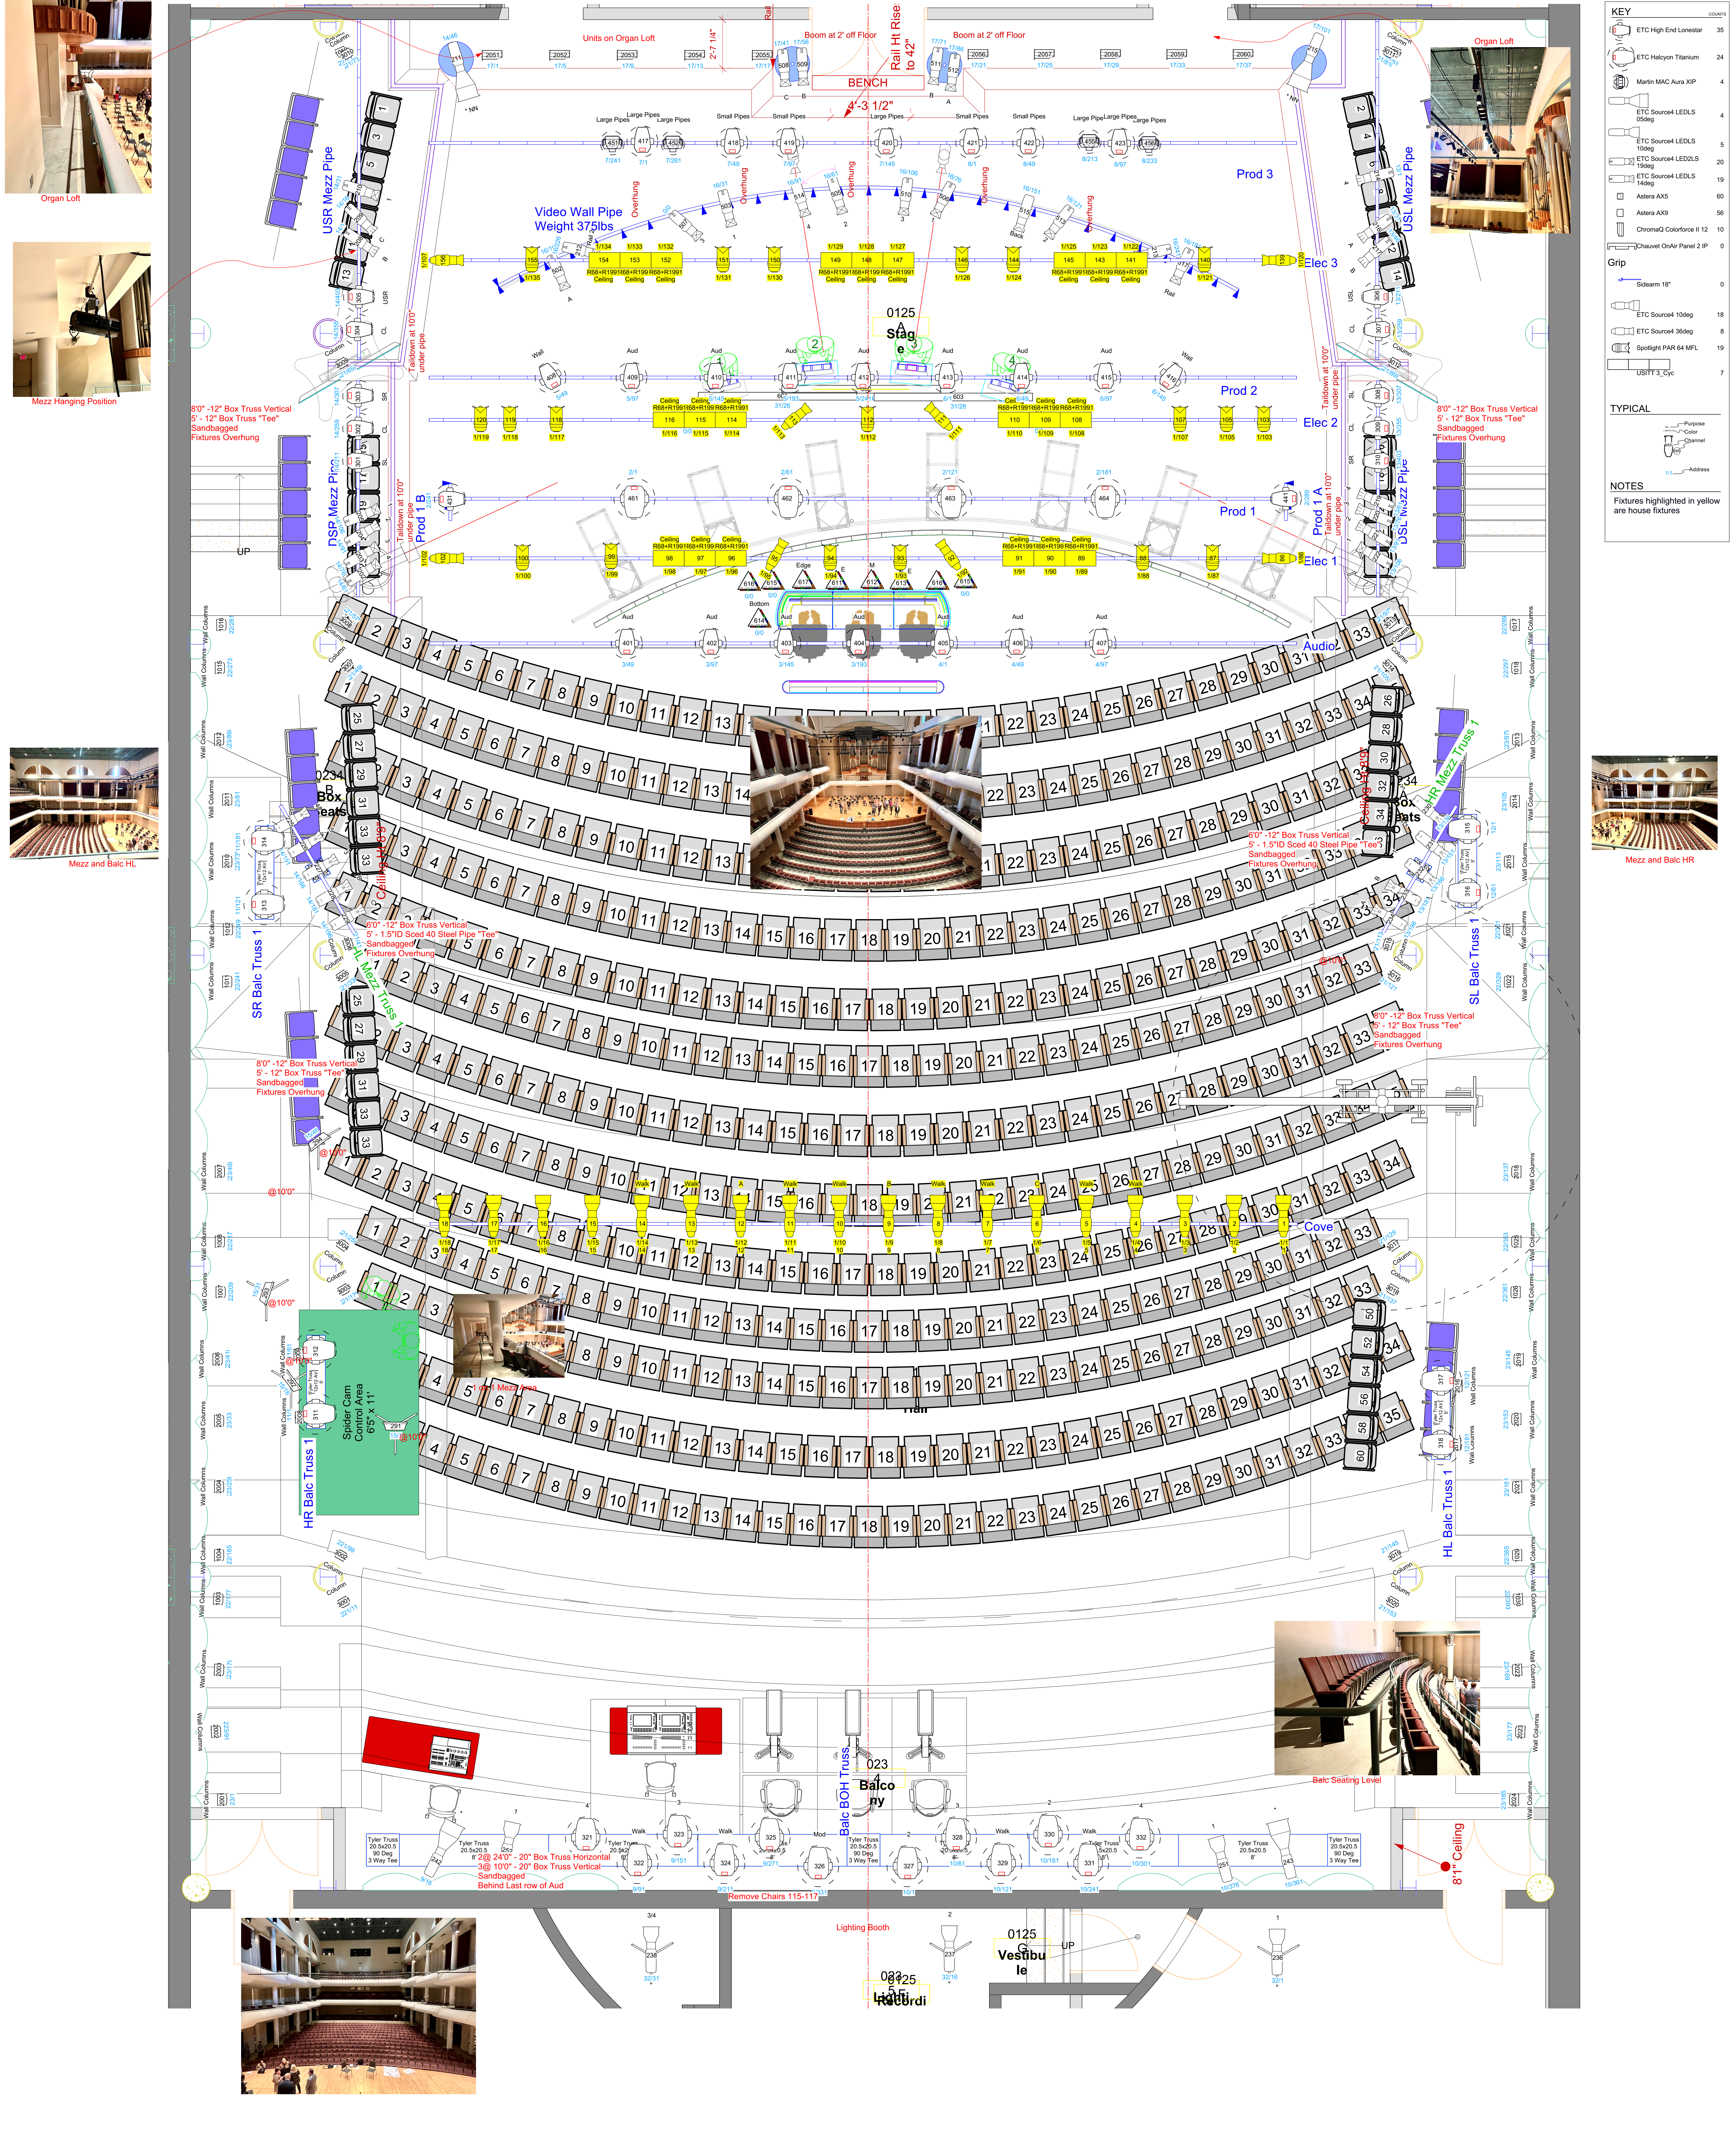


THIS DRAWING AND THE IDEAS, ARRANGEMENT, DESIGNS AND PLANS INDICATED HEREON OR REPRESENTED HERE ARE OWNED BY AND REMAIN THE EXCLUSIVE PROPERTY OF THE LIGHTING DESIGN GROUP (LDG). THEY HAVE BEEN CREATED AND DEVELOPED FOR USE ON AND IN CONNECTION WITH THIS SPECIFIED PROJECT ONLY AND MAY NOT BE USED FOR ANY OTHER PROJECT WITHOUT THE EXPRESS WRITTEN PERMISSION OF LDG. WRITTEN DIMENSIONS ON DRAWINGS SHALL HAVE AUTHORITY OVER SCALED DIMENSIONS. CONTRACTORS AND MANUFACTURERS SHALL VERIFY AND BE RESPONSIBLE FOR ALL DIMENSIONS AND JOBSITE CONDITIONS. ANY VARIATIONS OR DISCREPANCIES IN THE DRAWINGS SHALL BE REPORTED TO LDG PRIOR TO BEGINNING WORK. THESE DRAWINGS REPRESENT VISUAL CONCEPTS ONLY. RESPONSIBILITY FOR STRUCTURAL, RIGGING AND RELATED ENGINEERING IS BY OTHERS. ALL MEANS, METHODS AND MATERIALS TO MEET OR EXCEED APPLICABLE CODES AND INDUSTRY STANDARDS.

LDG The Lighting Design Group

49 West 27th Street, Suite 920
New York, NY 10001
Tel: (212) 695-4340
www.ldg.com

REVISIONS				
REV	DRW	DATE	DESCRIPTION	
1	ACK	10/6/2023	Test	
2	AKD	10/26/2023	Prelim Plot	
3	AKD	10/26/2023	Added Rooms	
4	ACK	10/30/2023	Site Survey Notes	
5	RAM	11/5/23	Redline Revisions	
6	ACK	11/13/2023	Scenic Update	
7	ACK	11/17/2023	Title Block Update	
8	CWD	12/7/23	Post-Show	

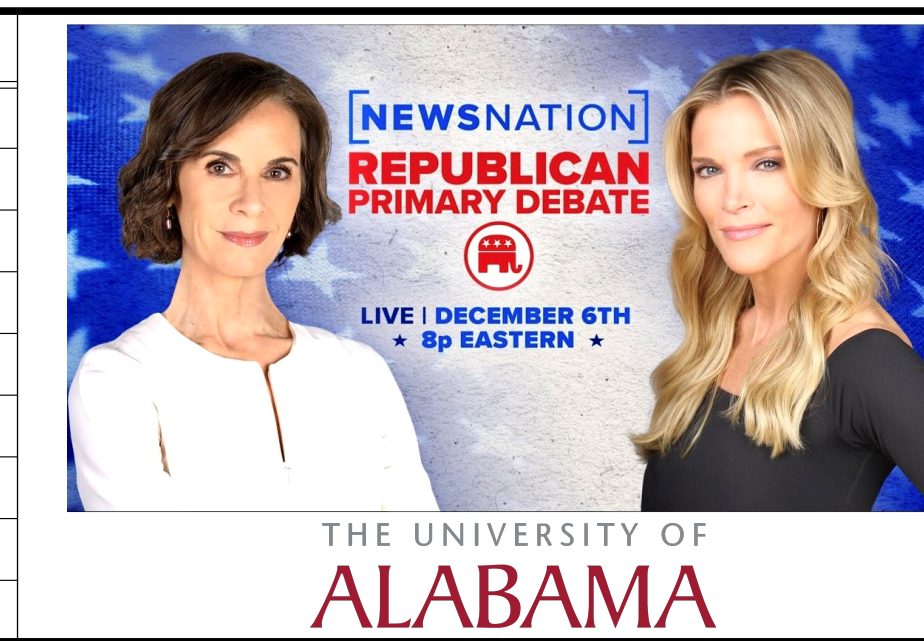

NewsNation Presents
4th GOP
Presidential Debate
at the
University of Alabama
in Tuscaloosa
Moody Music Building

Scale: NTS	Designer: Dennis Sizemore
Project ID: NMG2321	Drawn By: Alex Kyle-DiPietro
Drawing Date: 10/25/23	Show Date: 12/7/23
File Name: 20231206 - NMG2321 - NewsNation at Alabama University v8 v2024.wex	Facility: 810 2nd Ave, Tuscaloosa, AL 35401

Drawing Title: Whole Theater

Producer: NewsNation