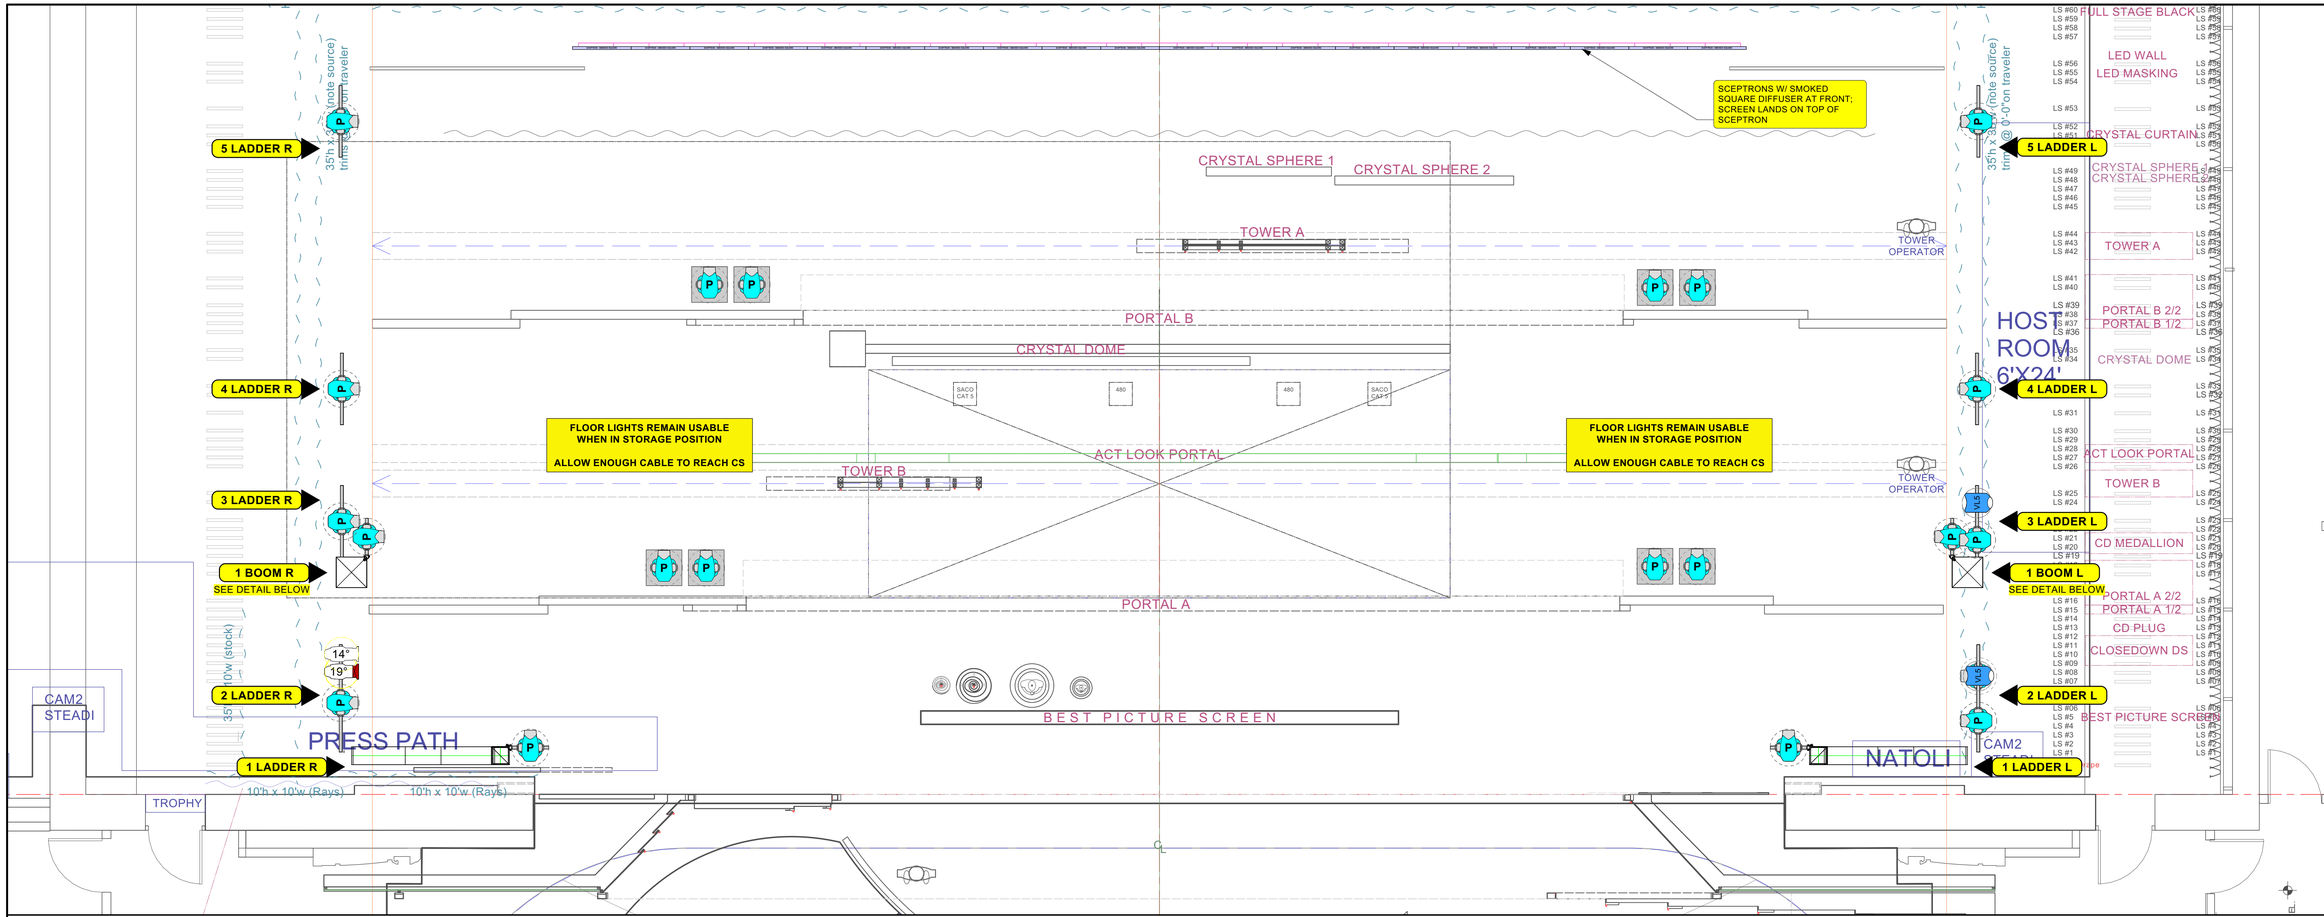

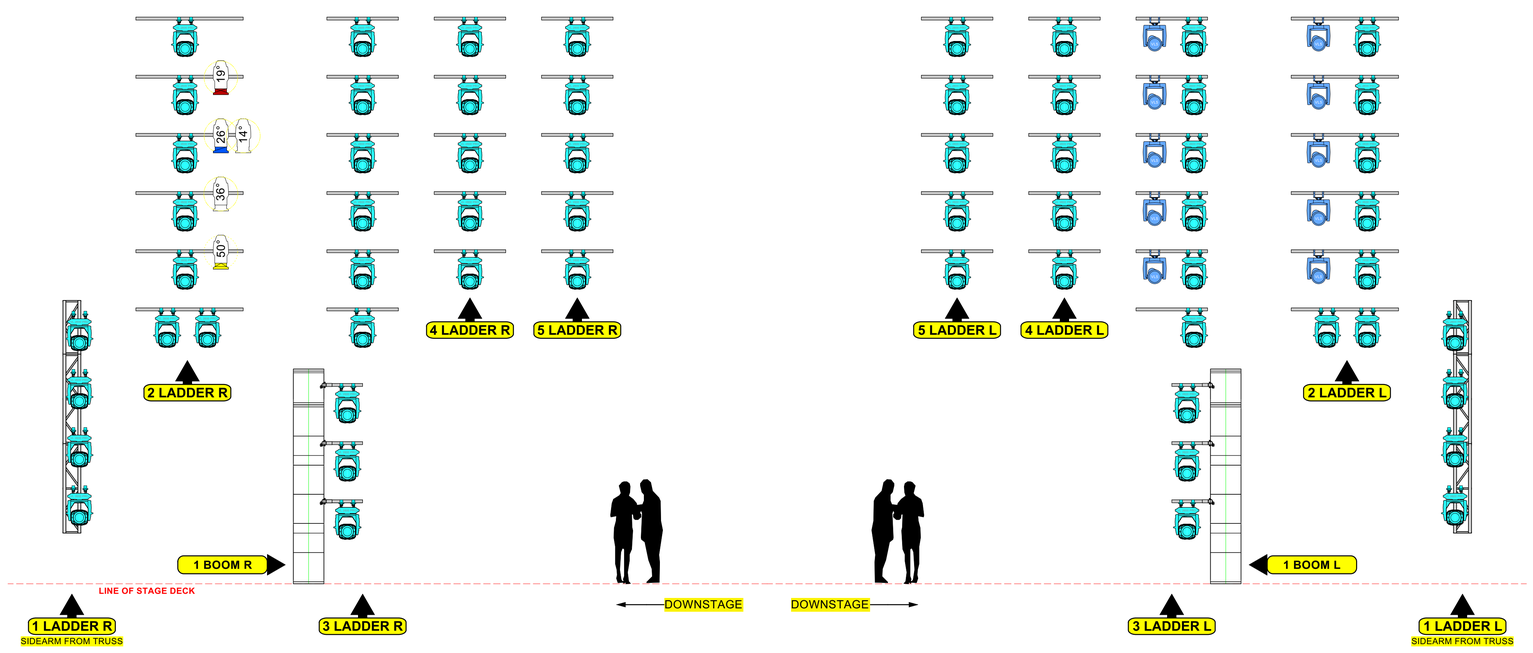

FULL FLOOD inc.
2397 Silver Lake Blvd. #22
Los Angeles, CA 90039
o. 323.665.6868 | f. 323.665.6967X

Please recycle this paper.

This document and the ideas and design incorporated herein, as an instrument of professional service, is the property of FULL FLOOD Inc. and is not to be used, in whole or part, for any other project without the written authorization of FULL FLOOD Inc. This document is not to be reproduced and/or modified in any way, nor shall any reproduction of this document be modified, with out prior written consent of FULL FLOOD Inc. This drawing represents visual concepts and construction documents only. Do not scale drawings. Contractor must verify all. Licensed structural engineer. The designer does not warrant, in any way, the accuracy of this information and shall not be responsible for discrepancies between this document and the existing conditions. The designer will not assume responsibility for improper engineering, construction, handling or use of this lighting equipment.

INSTRUMENT KEY

- BEST BOY GROUND CONTROL @ 2.1kw
- VL5 WASH @ 1.2kw
- VL2402 WASH @ 700w
- VL2600 PROFILE @ 820w
- Ayrton Diablo @ 550w
- VL3500 SPOT - DOLBY @ 1.2kw
- ARRI 300 @ 300w
- ARRI 650 @ 650w
- SKYPANEL S60-C @ 450w
- COLORBLAST TRX FROST @ 50w
- 10° Source 4 10 deg @ 750w
- 14° ETC Source 4 14 deg @ 750w
- 19° Source 4 19 deg @ 750w
- 26° Source 4 26 deg @ 750w
- 36° ETC Source 4 36 deg @ 750w
- 50° ETC Source 4 50 deg @ 750w
- 70° Source 4 70 deg @ 750w
- 90° Source 4 90 deg @ 750w
- S4 PAR WFL @ 750w
- Altman MicroStrip 1 Circ @ 350w
- Sceptron 40 - Round Diffuser @ 8.5w
- VL2600 GROUND CONTROL @ 820w

VENUE

THE DOLBY THEATRE, HOLLYWOOD, CA

SHOW

THE OSCARS

LOAD-IN	SHOWDAY	SHOW #
03/04/2022	3/27/22	2206

STAFF

DESIGNER	MITZ/DICKINSON
LEAD L.D.	M. BERGER
GAFFER	A. SISUL
PROG. 1:	A. O'REILLY
PROG. 2:	P. BOOZER
LEAD TECH	J. BEAGHAN

VERSION

01. PRELIMINARY 1-20-22
02. INST. UPDATE 2-21-22
03. REFL STUDY 2-24-22
04. DIABLO SWITCH 3-1-22
05. UPDATED FOH 3-14-22
06. AS BUILT 3-28-22

0" 1" 2"

PRINT ARCH D SHEET

DRAWN BY: J. BEHM

SCALE: 1/4"=1'-0"

CONTENTS

01. LX OVERHEAD
02. LX FLOOR/LADDERS
03. LX FOH
04. LX BOXES
05. 1ST ELEC.
06. ORCHESTRA/WW

SHEET #

LX-02

PUBLISH DATE: 03/28/2022

FLOOR + LADDERS