



This document and the ideas and design incorporated herein, as an act of professional service, is the property of 22° and is not to be whole or part, for any other project without the written authorization. This document is not to be reproduced nor modified in any way. All reproduction of this document is modified, with out prior consent of 22°. This drawing represents visual concepts and does not suggestions only; it does not replace the knowledge and advice received structural engineer. The designer does not warrant, in any way the accuracy of this information and shall not be responsible for omissions between this document and the existing conditions. The signer will not assume responsibility for improper engineering, construction, handling or use of this lighting equipment.

GLP Impression X4 @ 350w

Robe Robin 1200 LED Wash @ 680w


Philips Vari-Lite VL2600 Profile @ 520w

VariLite VL3600 @ 1.255kw

PRG GC Longthrow @ 1.5kw

TMB Solars Flare @ 1kw

Strong Gladiator III @ 3kw

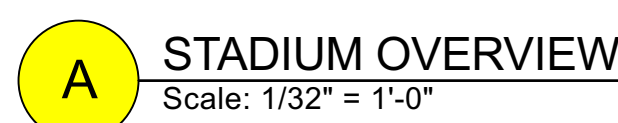

VENUE
STATE FARM STADIUM GLENDALE, AZ

AD-IN	SHOWDAY	SHOW #
02/23/23	02/12/23	#2305

DESIGNER	GURDON
LEAD L.D.	GREEN / FORSTER
GAFFER	SISUL
PROG. 1:	MARCHWINSKI
PROG. 2:	HUMPHREY
LEAD TECH	MINNOTTE

01. PRELIMINARY
02. 2023 CUTS 01/08/23
03. AS BUILT 02/09/23

[illegible]

1" 2"

PRINT ARCH E SHEET

DRAWN BY: BEG	SCALE: 1/32" = 1'-0"
DX-01: ROOF OVERVIEW	

LX-02: BOWL OVERVIEW
 LX-03: SIDELINE TRUSS
 LX-04: ENDZONE TRUSS
 LX-05: CORNER TRUSS
 LX-06: RING OF HONOR SW
 LX-07: RING OF HONOR NE
 LX-08: FIELD LAYOUT
 LX-09: SECTIONS

SHEET #
LV 01

LX-01

ISSUE DATE:
02/09/2023

ROOF OVERVIEW
