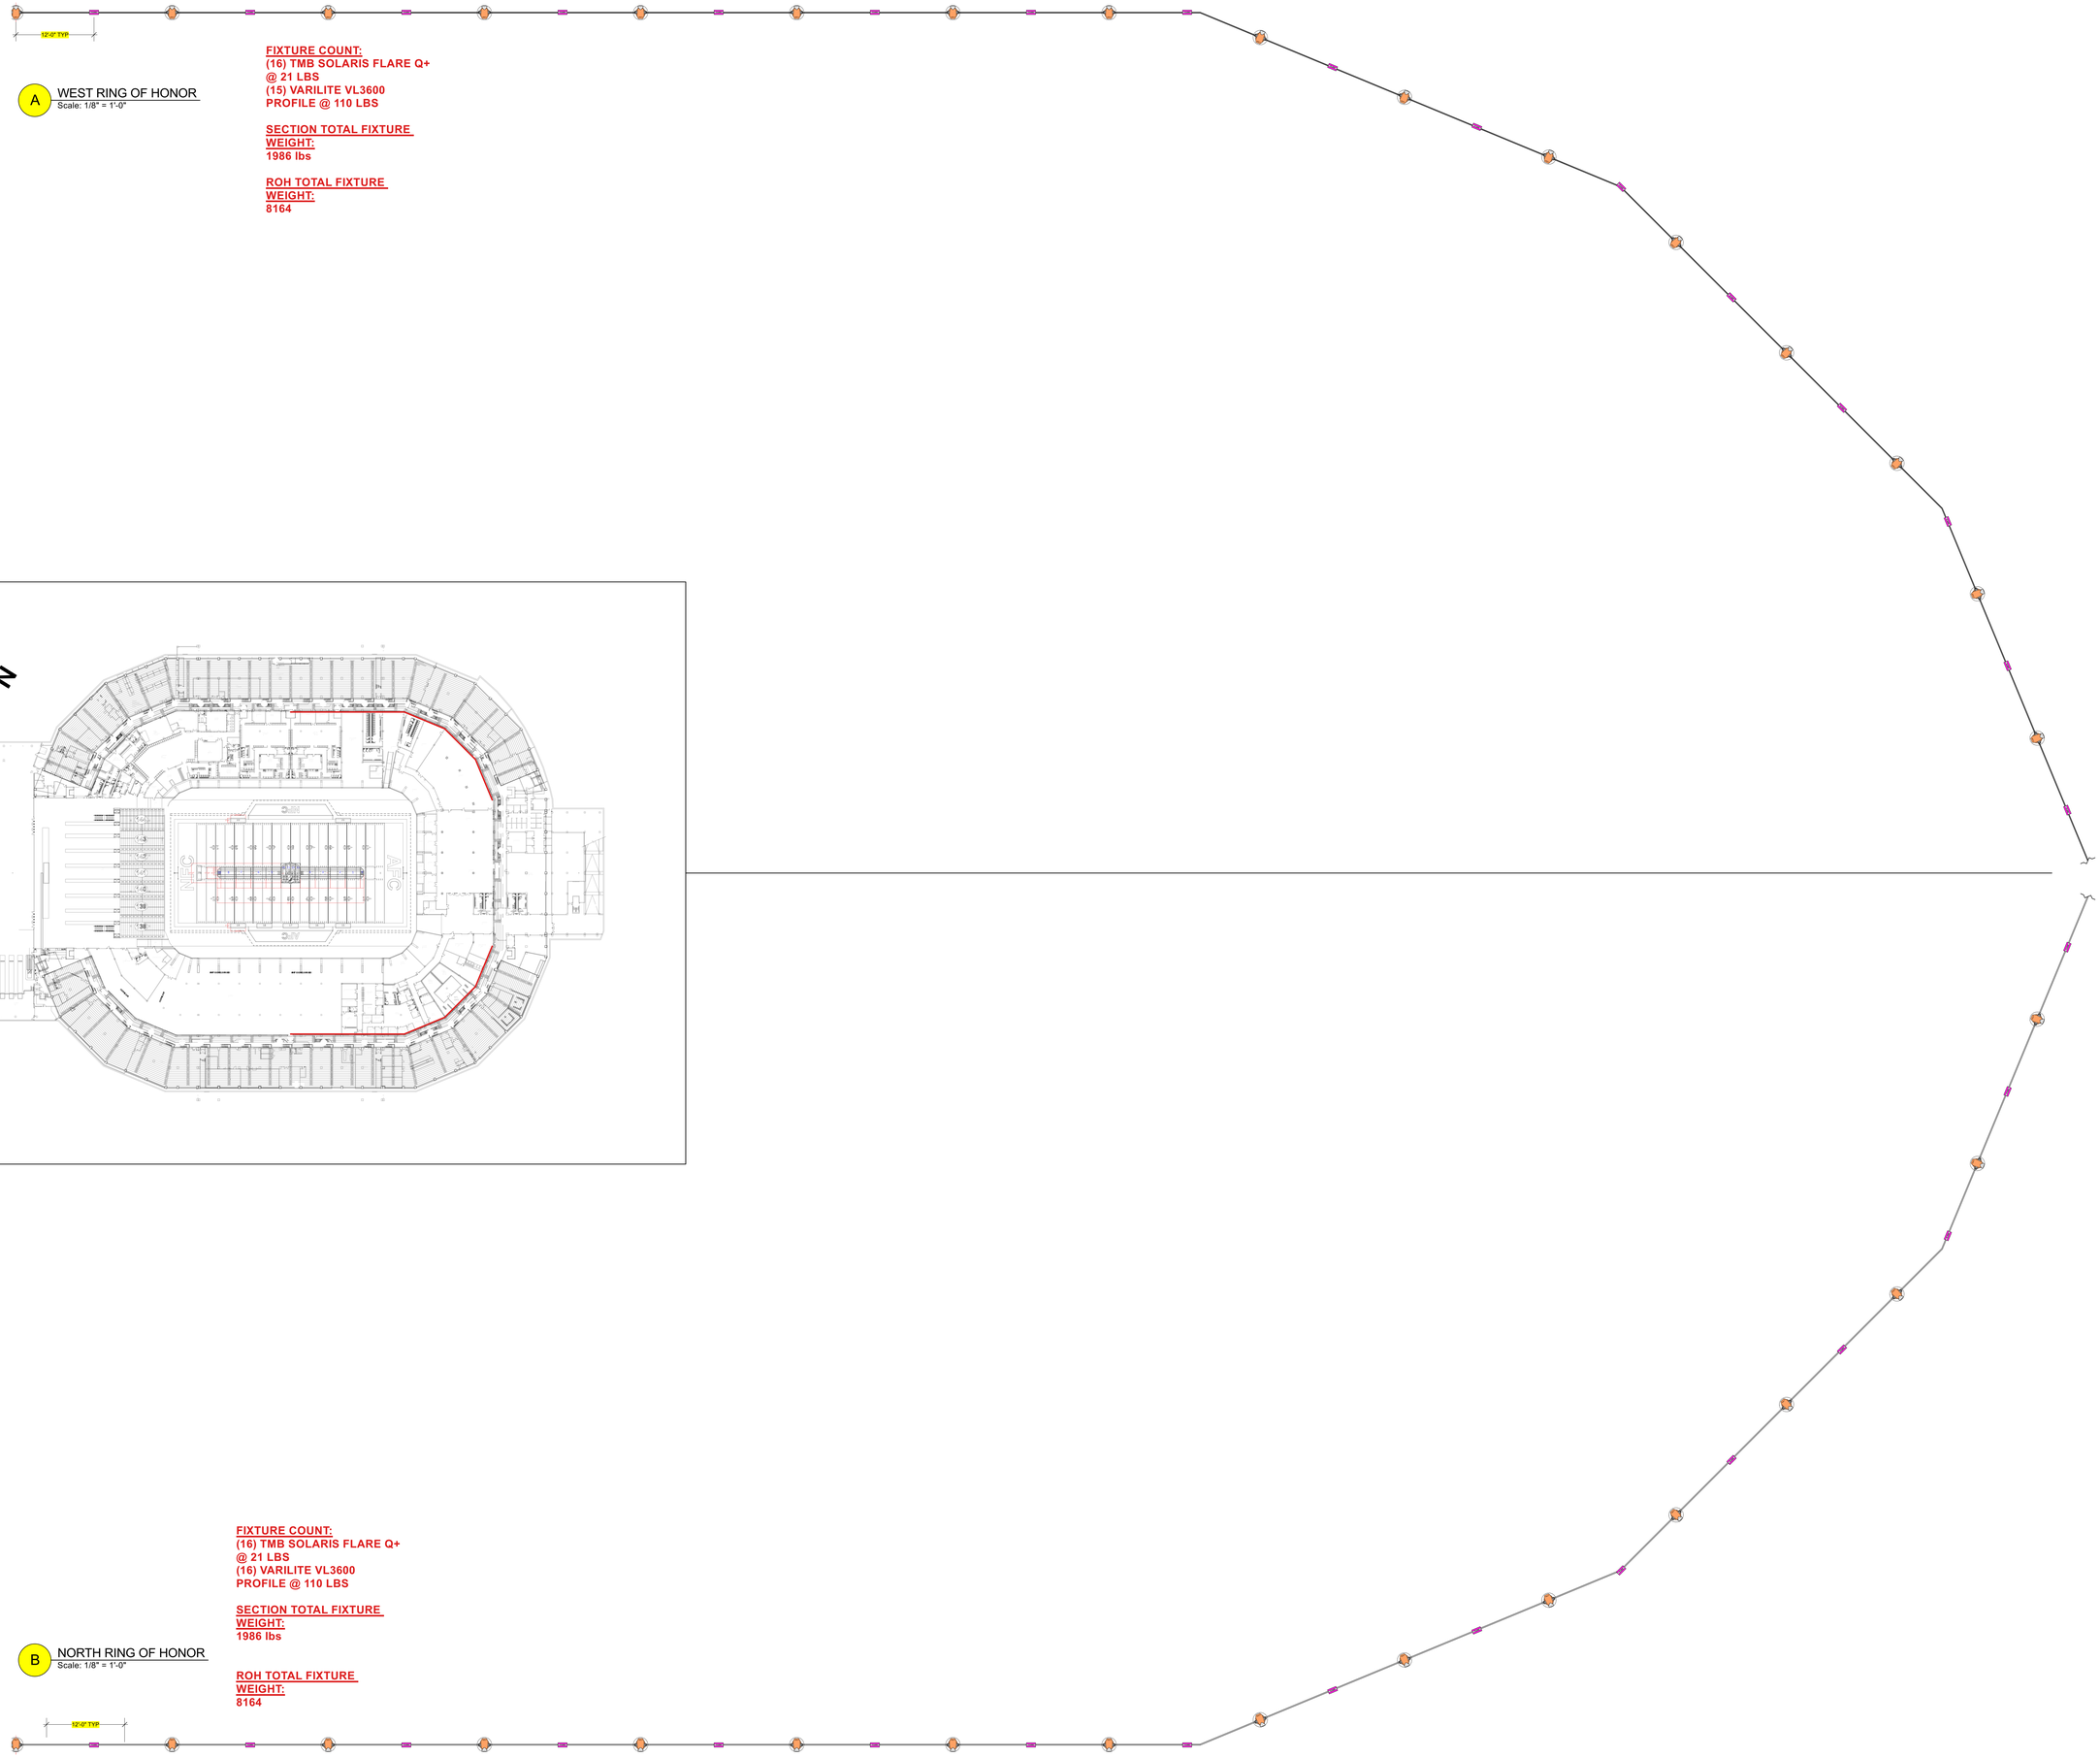

A WEST RING OF HONOR
Scale: 1/8" = 1'-0"

FIXTURE COUNT:
(16) TMB SOLARIS FLARE Q+
@ 21 LBS
(15) VARILITE VL3600
PROFILE @ 110 LBS

SECTION TOTAL FIXTURE WEIGHT:
1986 lbs

ROH TOTAL FIXTURE WEIGHT:
8164

FIXTURE COUNT:
(16) TMB SOLARIS FLARE Q+
@ 21 LBS
(16) VARILITE VL3600
PROFILE @ 110 LBS

SECTION TOTAL FIXTURE WEIGHT:
1986 lbs

ROH TOTAL FIXTURE WEIGHT:
8164

B NORTH RING OF HONOR
Scale: 1/8" = 1'-0"

12'-0" TYP

ENTERTAINMENT DESIGN GROUP

Please recycle this paper.

This document and the ideas and design incorporated herein, as an instrument of professional service, is the property of 22° and is not to be used in whole or part for any purpose without the written permission of 22°. This document is not to be reproduced and/or modified in any way nor shall any reproduction of this document be modified, with out prior written consent of 22°. This drawing represents visual concepts and construction suggestions only. It does not replace the knowledge and advice of a qualified engineer. 22° does not warrant the accuracy of this data in any way, the accuracy of this information and shall not be responsible for discrepancies between this document and the existing conditions. The engineer of record is responsible for the safe engineering, construction, handling or use of this lighting equipment.

INSTRUMENT KEY

GLP Impression X4 @ 350w

Robe Robin 1200 LED Wash @ 680w

Philips Vari-Lite VL2600 Profile @ 820w

Varilite VL3600 @ 1.505kw

PRG GC Longthrow @ 1.5kw

TMB Solaris Flare @ 1kw

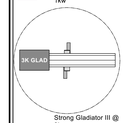

Strong Gladiator III @ 3kw

VENUE
STATE FARM STADIUM
GLENDALE, AZ

SHOW
SB 57 HALFTIME SHOW

INITIAL RLS	SCHEDULE	SHOW #
01/23/23	02/10/23	#2305

STAFF

DESIGNER	GURDON
LEAD L.D.	GREEN / FORSTER
GAFFER	SISUL
PROG. 1:	MARCHWINSKI
PROG. 2:	HUMPHREY
LEAD TECH	MINNOTTE

VERSION
01. PRELIMINARY
02. 2023 CUTS 01/08/23
03. AS BUILT 02/09/23

PRINT ARCH E SHEET

DRAWN BY:	SCALE:
BEG	1/4" = 1'-0"

CONTENTS

LX-01: ROOF OVERVIEW
LX-02: BOWL OVERVIEW
LX-03: SIDELINE TRUSS
LX-04: ENDZONE TRUSS
LX-05: CORNER TRUSS
LX-06: RING OF HONOR SW
LX-07: RING OF HONOR NE
LX-08: FIELD LAYOUT
LX-09: SECTIONS

SHEET #
LX-07

PUBLISH DATE:
02/09/2023

ROH NE