UTILITY NOTES:

1. SEE SHEET C1.01 FOR REFERENCES AND SHEET C2.01 FOR LEGEND.
2. LOCATIONS OF UNDERGROUND UTILITIES SHOWN HEREON WERE COMPILED FROM AVAILABLE RECORD PLANS OF UTILITY COMPANIES AND ARE APPROXIMATE AND ASSUMED. BEFORE COMMENCING SITE WORK, CONTRACTOR SHALL CALL "DIG SAFE" AT 1-888-344-7233 AND LOCAL MUNICIPAL UTILITY DEPARTMENTS TO ACCURATELY LOCATE UNDERGROUND UTILITIES. THE CONTRACTOR SHALL NOTIFY APPROPRIATE UTILITY COMPANIES / DEPARTMENTS OF ANY UTILITIES DAMAGED DURING CONSTRUCTION. ANY COSTS RELATED TO THE REPAIR OF UTILITIES DAMAGED AS A RESULT OF CONSTRUCTION ACTIVITY SHALL BE THE CONTRACTOR'S RESPONSIBILITY. NO EXCAVATION SHALL BE PERFORMED UNTIL ALL UTILITY COMPANIES HAVE BEEN NOTIFIED.
3. CONTRACTOR SHALL CONFIRM DEPTH(S) OF PERTINENT UTILITIES BY TEST FIT AND NOTIFY OWNER'S REPRESENTATIVE OF ANY DISCREPANCIES.
4. ALL DRAIN PIPE SHALL BE CPE (TYPE S) (ADS N12 OR EQUAL), UNLESS OTHERWISE NOTED. PIPE LENGTHS ARE MEASURED CENTER-OF-STRUCTURE TO CENTER-OF-STRUCTURE.
5. ALL WATER MAIN PIPE AND FITTINGS SHALL BE CLDI CLASS 52 (AWWA C151, C110 & C104) WITH RUBBER GASKETED JOINTS (AWWA 111), UNLESS OTHERWISE NOTED. ALL WATER SERVICES TO BE PRESSURE RATED TYPE K COPPER BY AN AMERICAN MANUFACTURER AS REQUIRED/APPROVED BY DPW.
6. WHERE 10' HORIZONTAL SEPARATION BETWEEN SEWER AND WATER MAINS CANNOT BE MAINTAINED, CROWN OF SEWER MAIN SHALL BE 18" BELOW BOTTOM OF WATER MAIN, IN ACCORDANCE WITH SECTION 9.1.2 OF MASS. DEP "GUIDELINES AND POLICIES FOR PUBLIC WATER SYSTEMS" (AS DEFINED IN 310 CMR 22.02).
7. PROPOSED GAS, ELECTRIC, TELEPHONE AND CABLE DEPICTED IS SCHEMATIC ONLY. CONTRACTOR SHALL COORDINATE WITH RESPECTIVE UTILITY COMPANY FOR FINAL PLANS AND SPECIFICATIONS.
8. CONTRACTOR SHALL COORDINATE CONNECTION TO MUNICIPAL FIRE ALARM.
9. THE PROPOSED IMPROVEMENTS SHOWN HEREON ARE SUBJECT TO THE CONDITIONS SET FORTH IN THE SITE PLAN SPECIAL PERMIT CONDITIONAL APPROVAL ISSUED BY THE ZONING BOARD OF APPEALS IN JULY 2008.

Notes:

PROJECT PROPOSES NO CHANGES TO EXISTING UTILITIES OR SITE LIGHTING

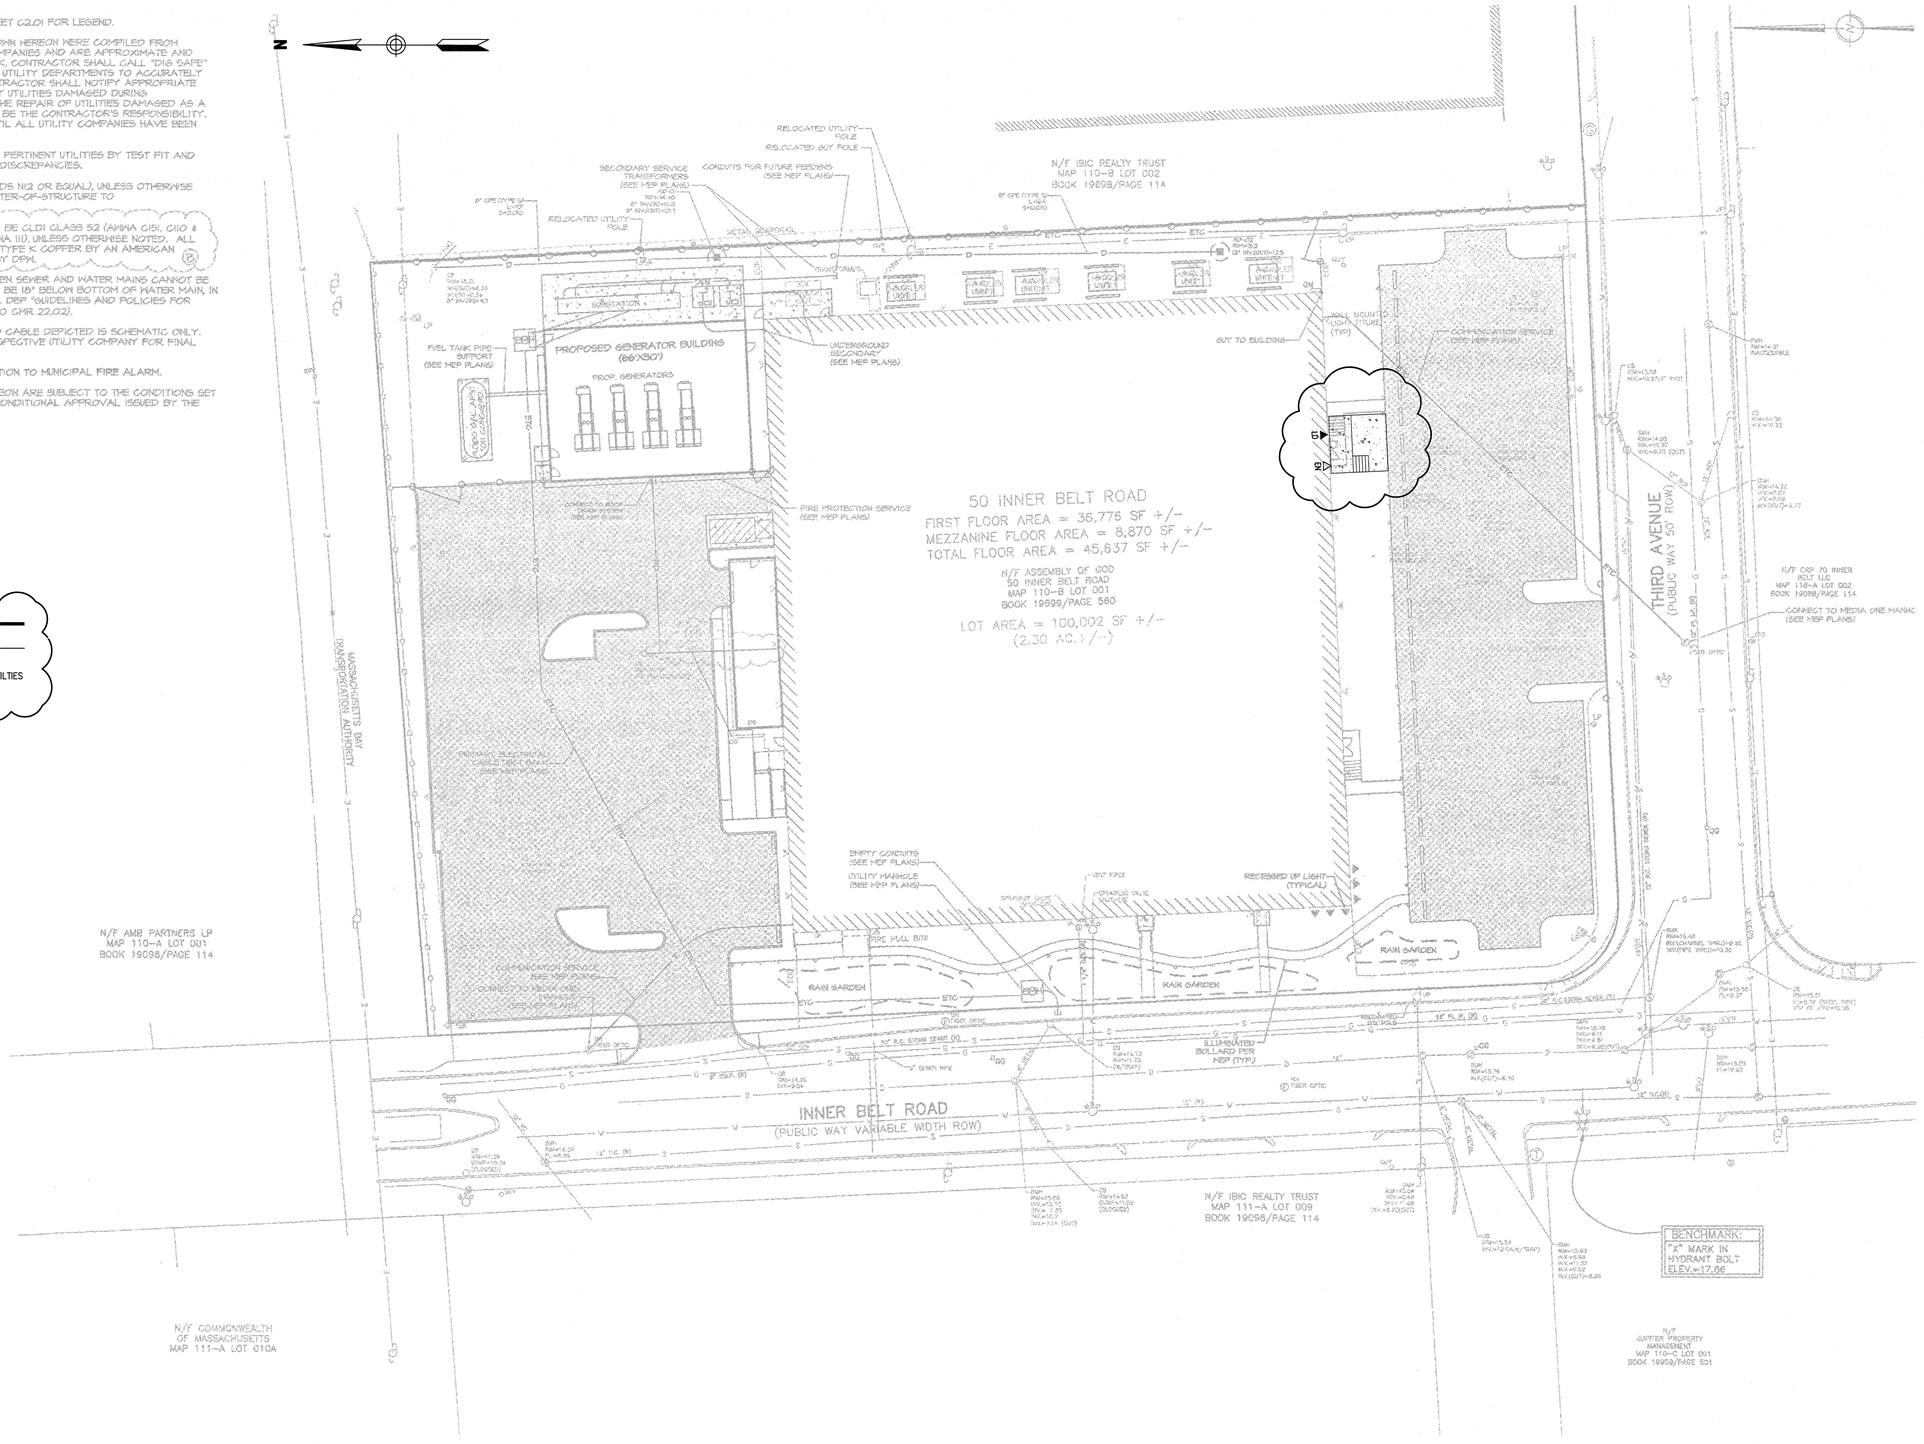

20 0 20 40
SCALE IN FEET

THIS DRAWING IS NOT FOR CONSTRUCTION

VHB
Vanasse Hangen Brustlin, Inc.
Transportation
Land Development
Environmental Services
101 Walnut Street, P.O. Box 9151
Watertown, Massachusetts 02471
617.924.1770 • FAX 617.924.2286

No.	Revision	Date	Appvd.
1	Loading Dock and Door	2/14/13	HGH

Designed by DAG	Drawn by DAG	Checked by HGH	
CAD checked by DAG	Approved by HGH		
Scale 1"=20'	Date February 14, 2013		

Project Title
InterNAP Network Services
Loading Dock/Door

50 Inner Belt Road
Somerville, MA

Issued for
Special Permit with
Site Plan Review

Not Approved for Construction

Drawing Title
Utility Plan

COMMONWEALTH OF MASSACHUSETTS
HUGH G HAHN
CIVIL
No. 40979
REGISTERED PROFESSIONAL ENGINEER
2/19/13

Drawing Number
C-3

Sheet 3 of 5

Project Number
12265.00

12265.00_UT.DWG