PLANTING & LIGHTING NOTES:

1. SEE SHEET G1.01 FOR REFERENCES AND SHEET G2.01 FOR LEGEND.
2. ALL PLANT MATERIAL SHALL CONFORM TO THE MINIMUM GUIDELINES AS OUTLINED BY THE AMERICAN STANDARD FOR NURSERY STOCK PUBLISHED BY THE AMERICAN ASSOCIATION OF NURSERYMEN, INC.
3. ANY PROPOSED SUBSTITUTION OF PLANT MATERIAL SHALL BE EQUAL IN OVERALL HEIGHT, LEAF, FORM, BRANCHING HABIT, FRUIT, FLOWER, COLOR, AND CULTURE.
4. LAWN AREAS ARE TO BE LOAMED AND SEEDED UNLESS OTHERWISE NOTED.
5. ALL LANDSCAPE ISLANDS WITHIN PARKING AREAS ARE TO BE BARK MULCHED TO A MINIMUM DEPTH OF 3" UNLESS OTHERWISE NOTED.
6. ALL PLANTING BEDS ARE TO BE CROWNED WITH TOPSOIL ABOVE ADJACENT AREAS.
7. PROVIDE A PLANTING BED WITH A MINIMUM DIAMETER OF 5' AROUND ALL TREES NOT LOCATED WITHIN A PLANTING BED. PROVIDE A CONTINUOUS MULCH BED AROUND ALL SHRUB PLANTINGS AS INDICATED ON THE PLANS.
8. PROVIDE A MINIMUM 3' GRASS STRIP ALONG ALL CURB LINES AS INDICATED ON THE PLANS.
9. ALL TREE PLANTINGS TO MAINTAIN A 10 FOOT HORIZONTAL SEPARATION FROM PROPOSED AND EXISTING SEWER AND WATER LINES.
10. CONTRACTOR IS RESPONSIBLE FOR PROVIDING PROPER IRRIGATION TO ALL PLANT MATERIAL. IRRIGATION DESIGN AND PERMITTING TO BE PROVIDED BY OTHERS.
11. PLANTING BEDS AND PEASTONE MEANDERING PEDESTRIAN WALKWAY TO BE INSTALLED WITH A METAL EDGING.
12. THE PROPOSED IMPROVEMENTS SHOWN HEREON ARE SUBJECT TO THE CONDITIONS SET FORTH IN THE SITE PLAN SPECIAL PERMIT CONDITIONAL APPROVAL ISSUED BY THE ZONING BOARD OF APPEALS IN JULY 2008.

PLANT LEGEND:

- EXISTING DECIDUOUS TREE TO REMAIN
- NEW DECIDUOUS TREES
- NEW DECIDUOUS/EVERGREEN SHRUBS
- NEW EVERGREEN TREES

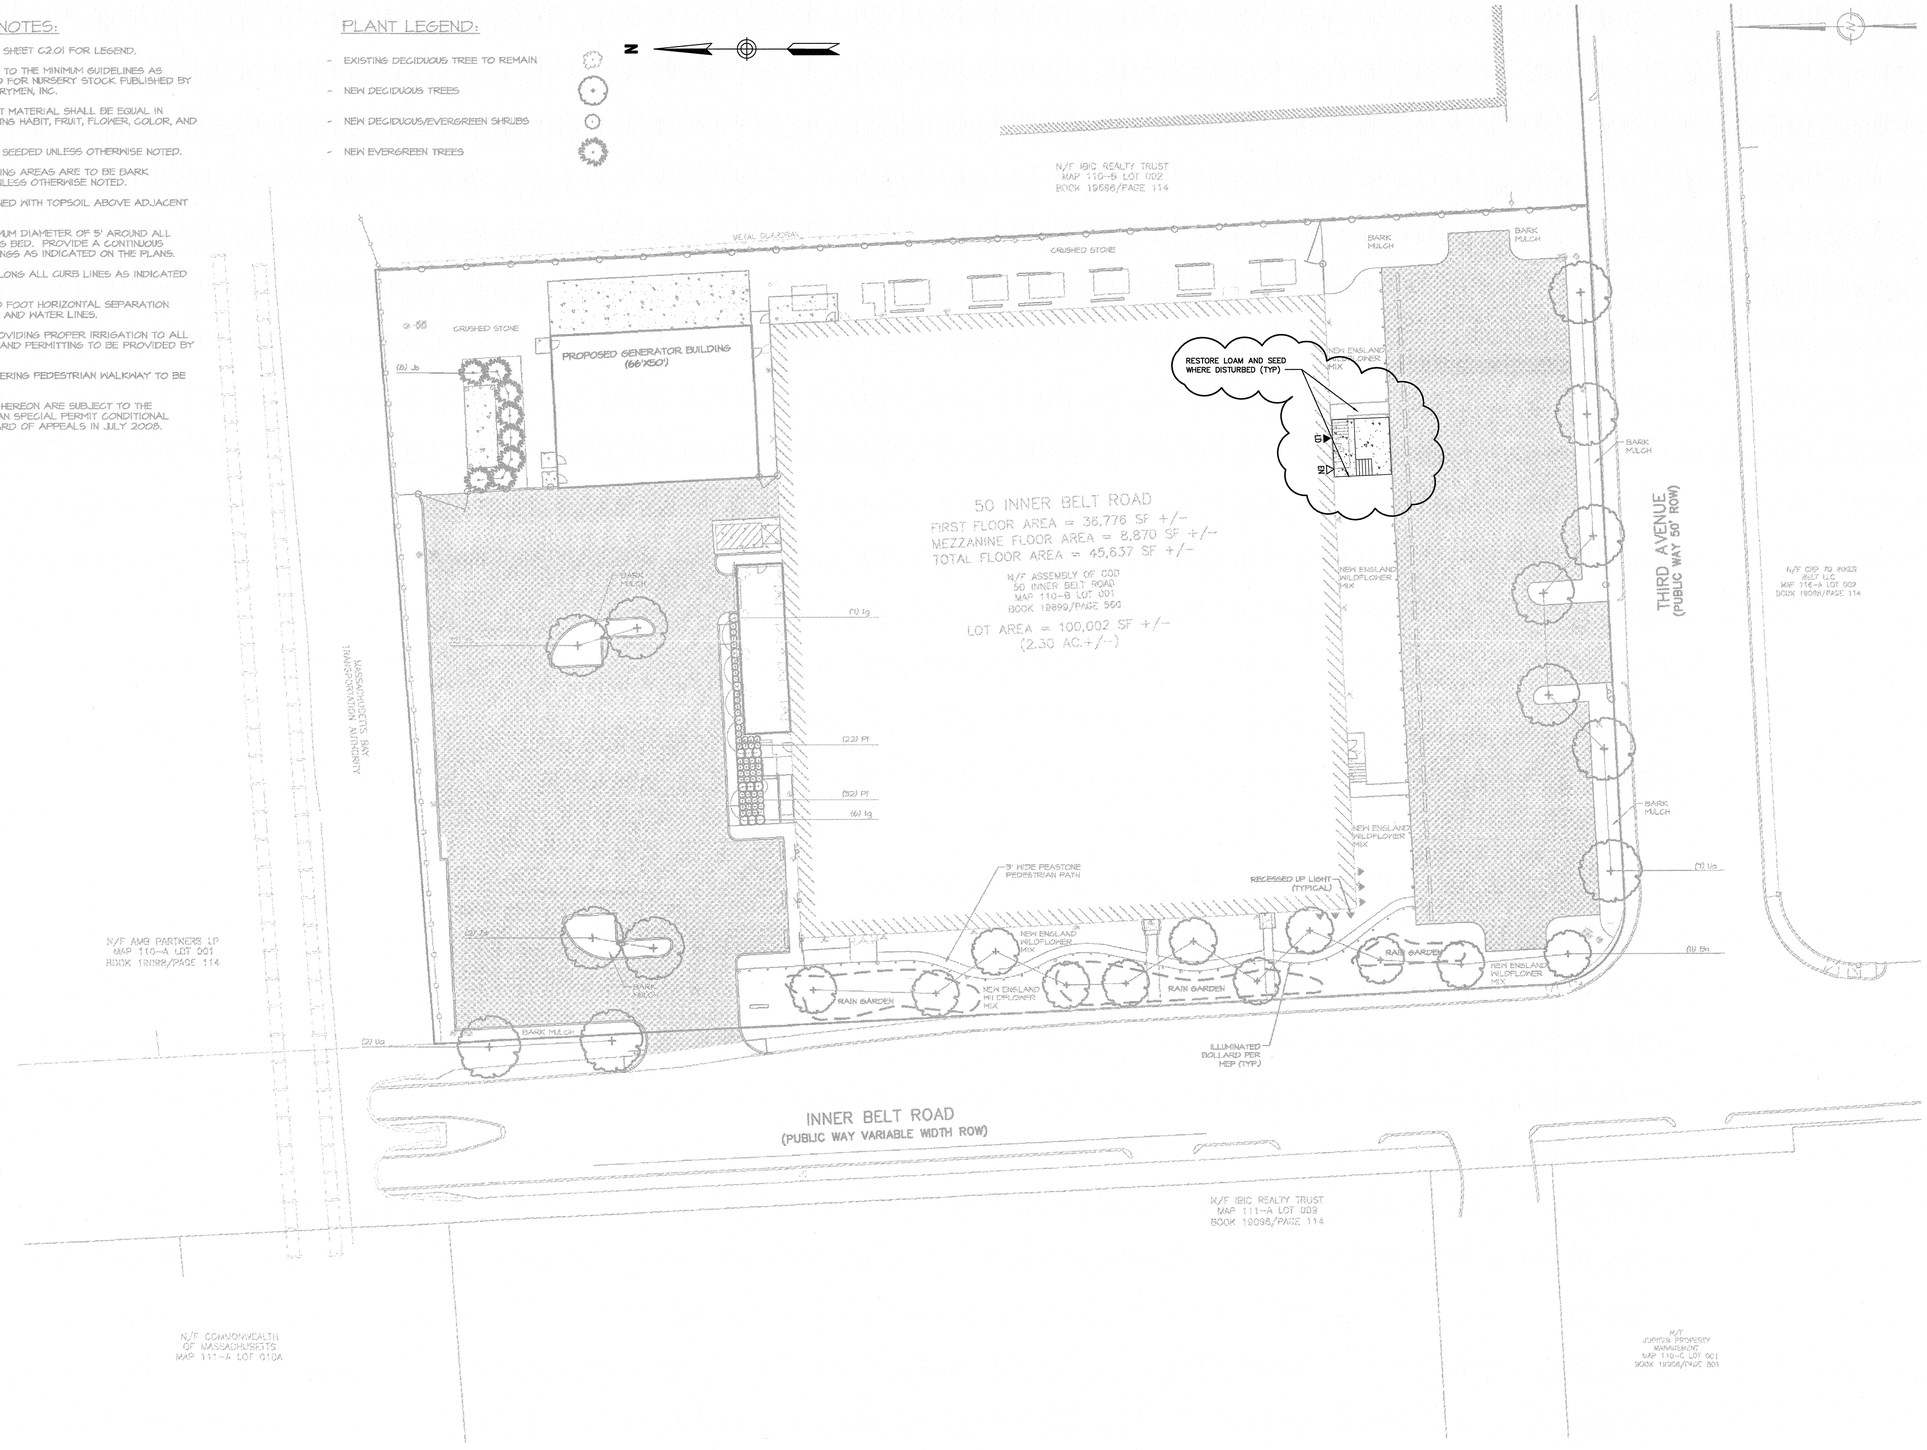

PLANT SCHEDULE					
QTY	KEY	BOTANICAL	COMMON	SIZE	CONDITIONS
TREES					
11	Bn	Betula nigra 'Cully'	Heritage River Birch - Clump	10'-12' Clump	B&B
8	Js	Juniperus scopulorum 'Skyrocket'	Skyrocket Juniper	8' - 10' Ht.	B&B
9	Ua	Ulmus 'Accolade'	Accolade Elm	3" - 3 1/2" Cal.	B&B
4	Zs	Zelkova serrata 'Green Vase'	Green Vase Japanese Zelkova	3" - 3 1/2" Cal.	Ball & Burlap
SHRUBS					
13	Ig	Ilex glabra 'Shamrock'	Shamrock Inkberry	24" - 30" Ht.	B&B
54	Pf	Potentilla fruticosa 'Longacre'	Longacre Cinquefoil	18" - 24" Ht.	Container
GRASSES					
1,000	S.F.	New England Wildflower Mix		Hydroseed	See Specs.

20 0 20 40
SCALE IN FEET

THIS DRAWING IS NOT FOR CONSTRUCTION

VHB
Vanasse Hangen Brustlin, Inc.
Transportation
Land Development
Environmental Services
101 Walnut Street, P.O. Box 9151
Watertown, Massachusetts 02471
617.924.1770 • FAX 617.924.2286

No.	Revision	Date	Approd.
1	Loading Dock and Door	2/14/13	HGH

Designed by DAG | Drawn by DAG | Checked by HGH
CAD checked by DAG | Approved by HGH
Scale 1"=20' | Date February 14, 2013

Project Title
InterNAP Network Services
Loading Dock/Door

50 Inner Belt Road
Somerville, MA

Issued for
Special Permit with
Site Plan Review

Not Approved for Construction

Drawing Title
Planting Plan

COMMONWEALTH OF MASSACHUSETTS
HUGH G. HAWN
CIVIL
No. 43879
REGISTERED PROFESSIONAL ENGINEER
02/19/15

Drawing Number
C-4

Sheet 4 of 5

Project Number
12265.00

12265.00_LA.DWG