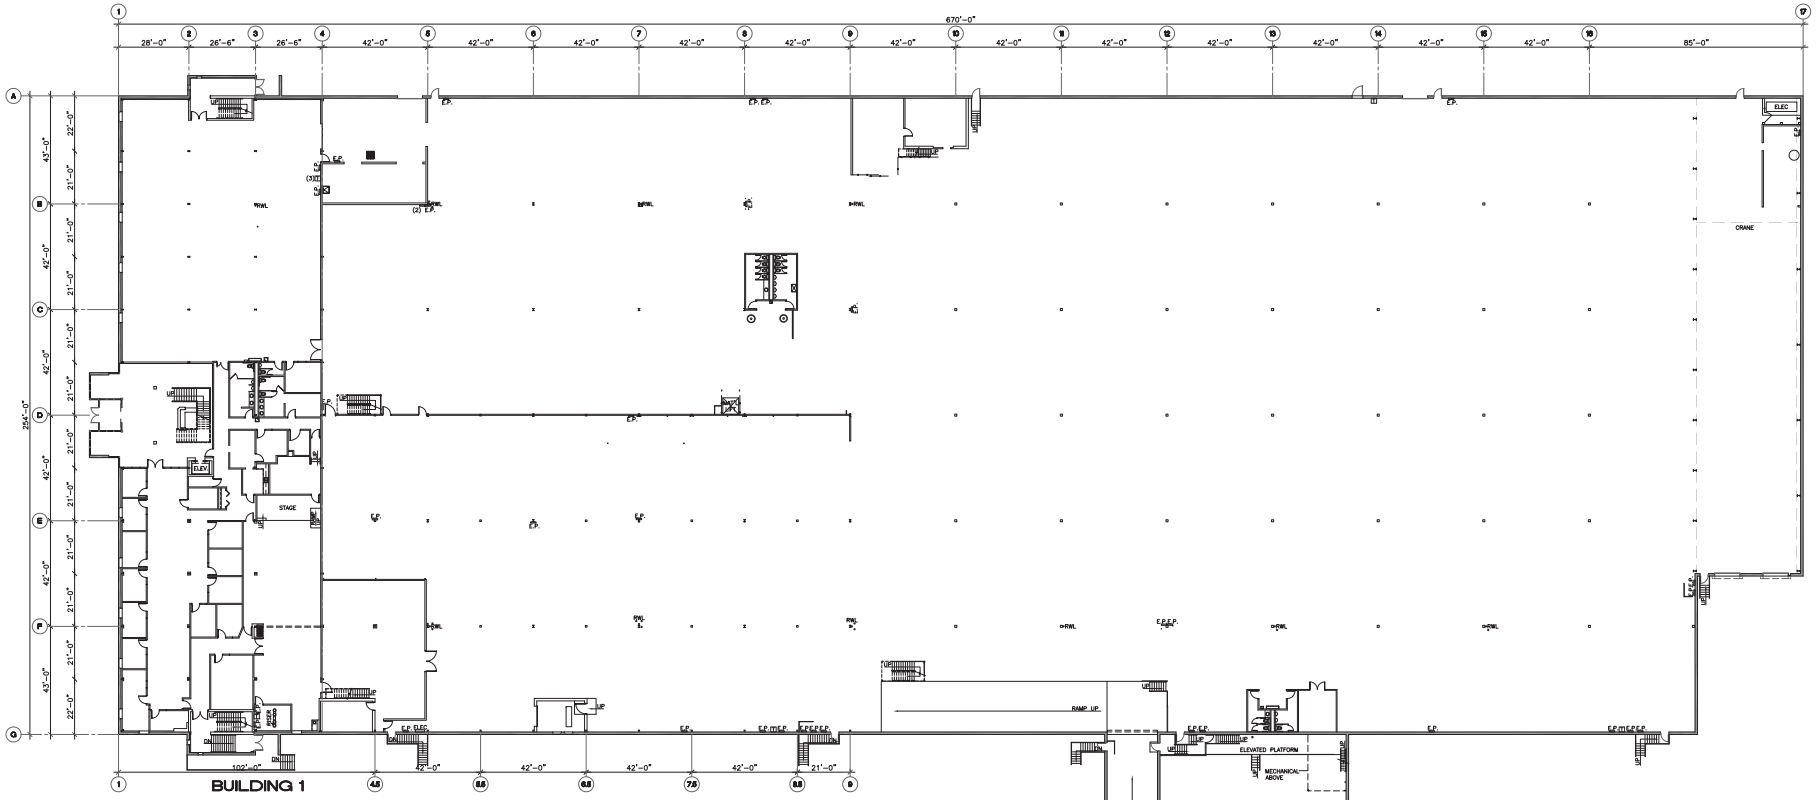

1 / A1 EXISTING FLOOR PLAN - BUILDING 1 (1ST FLOOR)
1" = 20'-0"

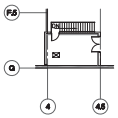

1 / A1 EXISTING FLOOR PLAN - BUILDING 1 (INTERMEDIATE LEVEL)
1" = 20'-0"

Wolf's Drafting & Design
8214 Aberdeen Trail
Northfield, MN 55057
(612) 363-2204
nwolf803@msn.com

PROPERTY MANAGED BY
TRANSWESTERN
3775 NORTH DUNLAP
ARDEN HILLS, MN 55112
(651) 481-9070
(651) 481-0830
FAX
COMMERCIAL REAL ESTATE

REVISIONS
1
2
3
4
5
6

© 2017 Wolf's Drafting & Design
All rights reserved.
THIS DOCUMENT IS AN INSTRUMENT OF SERVICE AND IS THE PROPERTY OF WOLF'S DRAFTING & DESIGN AND MAY NOT BE USED OR REPRODUCED WITHOUT PRIOR WRITTEN CONSENT.

EXISTING FLOOR PLAN FOR:
Circle Star Business Center
14600 21st Avenue North
PLYMOUTH, MN

AS BUILT
FLOOR PLAN
BUILDING 1 - 1ST FL.

DATE
02/17/17

A1

PROJECT NO.
17004